


T.2S.R.1E.W.M.

+ 2755

+ 4056

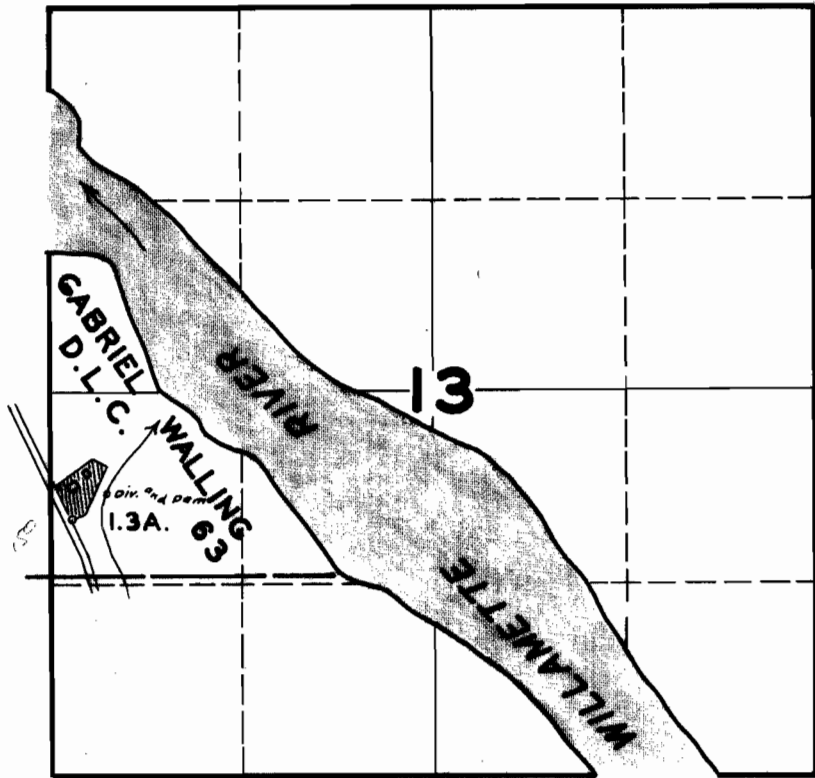

+ 2871

+ 4057

FINAL PROOF SURVEY UNDER

Application No. 20785 Permit No. 16265

IN NAME OF

JACK E. JOHNSON & EVELYN L. JOHNSON

Surveyed JUN. 20 1947, by JAS. E. BUNNELL