


T.17S.R.1E.W.M.

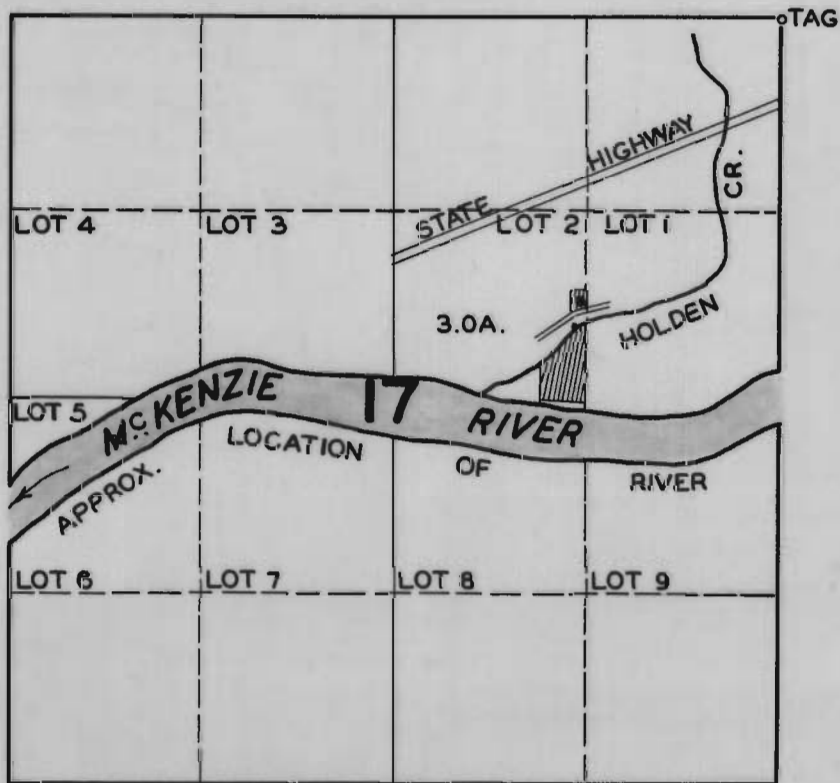

FINAL PROOF SURVEY UNDER

Application No. **20821** Permit No. **16292**
IN NAME OF

C.V. LANSBERRY

Surveyed **JUNE 16, 1948**, by **JAS. E. BUNNELL**