


T.5S.R1.W.W.M.

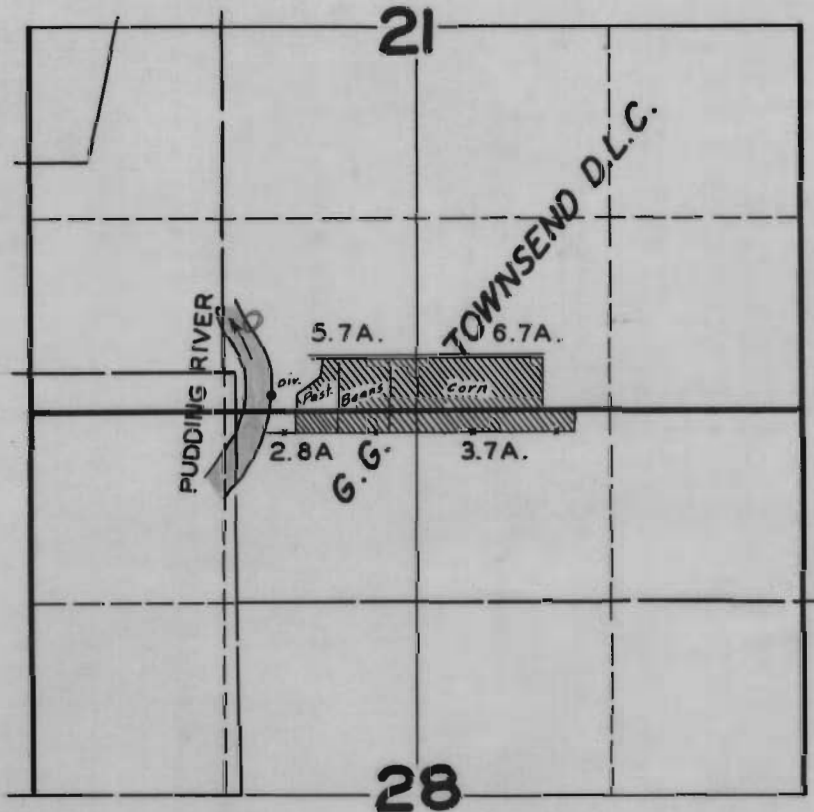

FINAL PROOF SURVEY UNDER

Application No. 20829 Permit No. 16298

IN NAME OF

RAY M. LAUGHLIN

Surveyed JUL. 29 1947, by JAS. E. BUNNELL