


**T.2S.R.1E.W.M.**

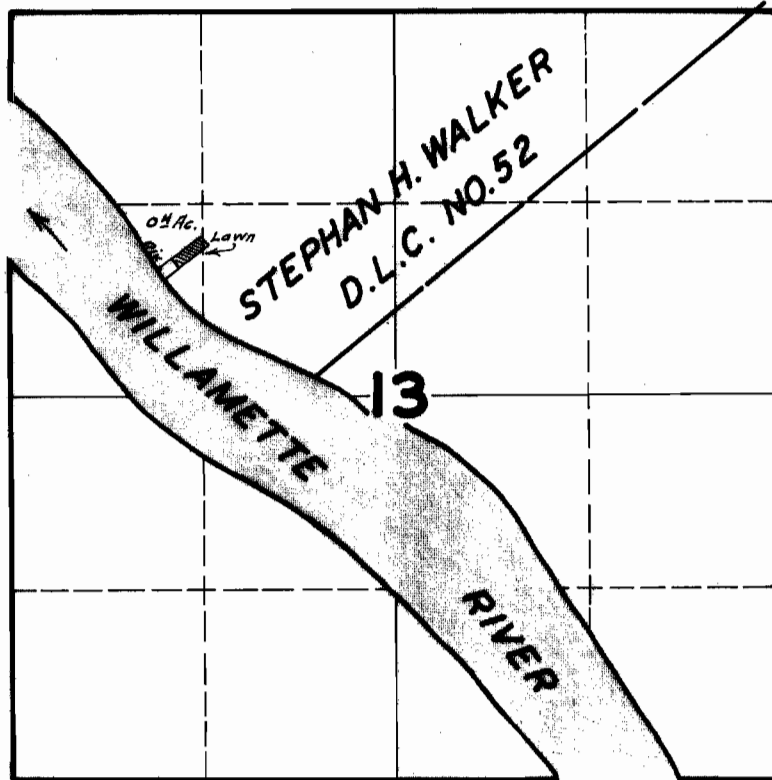

**FINAL PROOF SURVEY  
UNDER**

**Application No. 20834 Permit No. 16301**

**IN NAME OF**

**H. H. JESSOP**

**Surveyed JUN. 11, 1947, by JAS. E. BUNNELL**