


T.4S.R.4E.W.M.

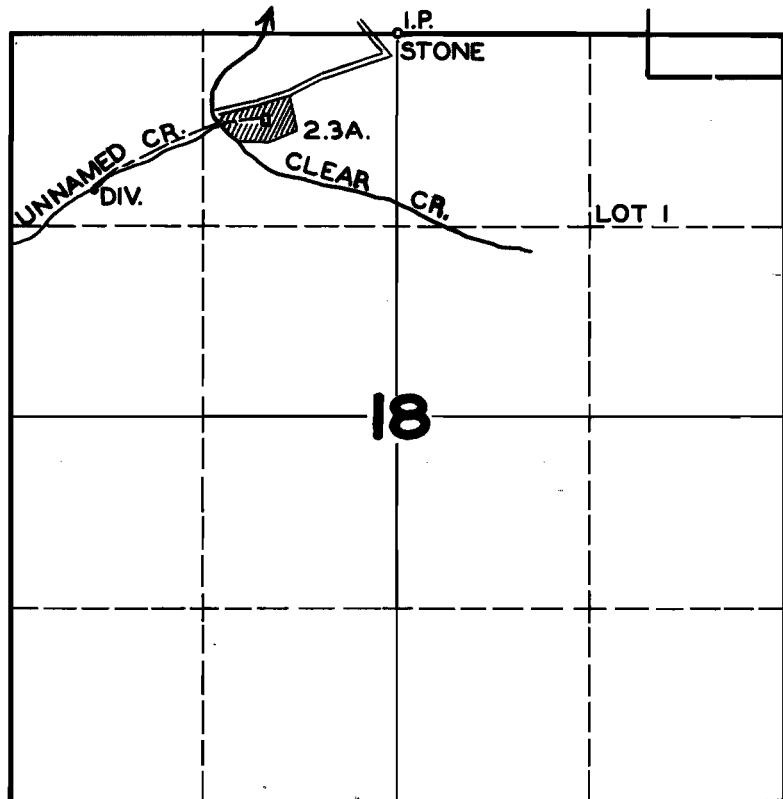

FINAL PROOF SURVEY
UNDER

Application No. **20851**... Permit No. **16309**...
IN NAME OF

W.B. ODALE & T.M. ODALE

Surveyed **AUG. 6, 1948**, by **JAS. E. BUNNELL**