


T.14S.R.1W.W.M.

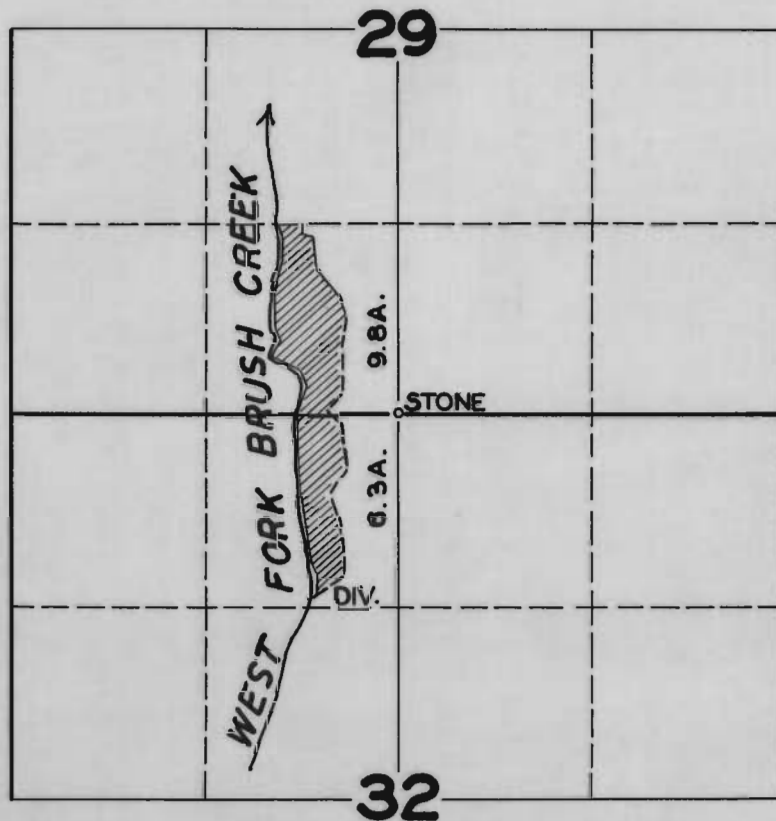

FINAL PROOF SURVEY

UNDER:

Application No. 20826 Permit No. 15325

IN NAME OF

WM. W. HALEY & MABEL R. HALEY

Surveyed MAR. 29 1949, by JAS. E. BUNNELL