


T.9S.R.3W.W.M.

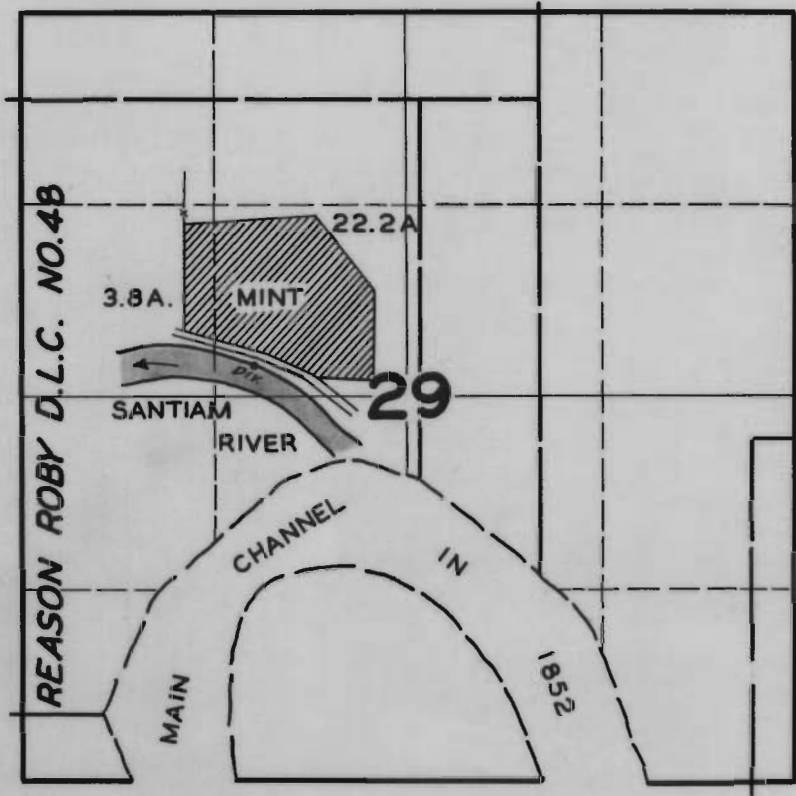

**FINAL PROOF SURVEY
UNDER**

Application No. 20831 Permit No. 16328

IN NAME OF

ALBERT E. COLE

Surveyed OCT. 24 1947, by JAS. E. BUNNELL