


T.I.S.R.I.W.W.M.

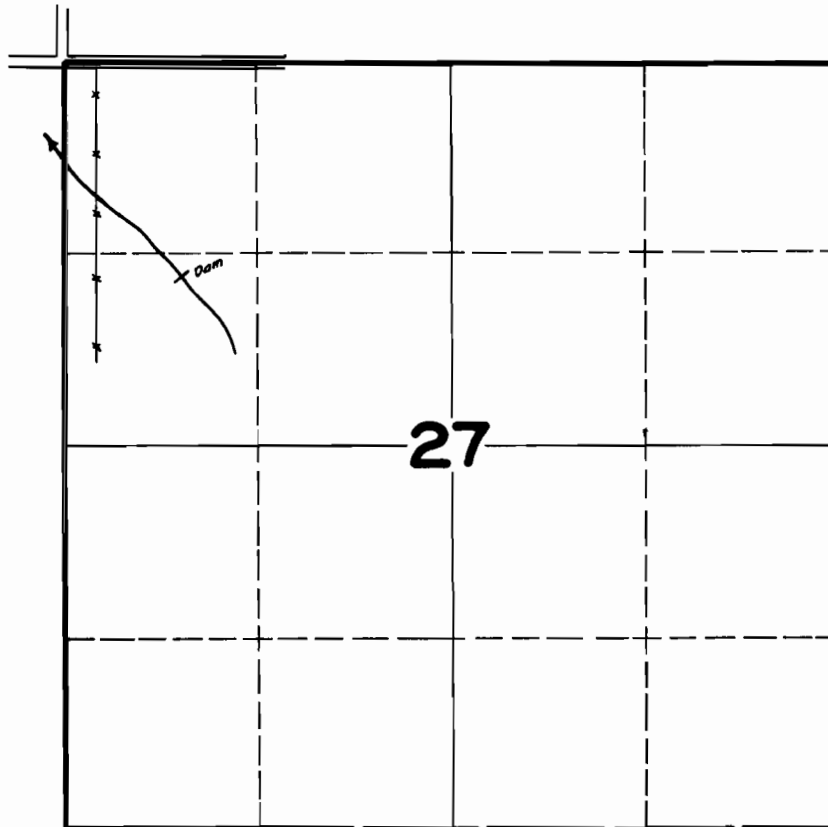

**FINAL PROOF SURVEY**  
**UNDER**

Application No. 20766 Permit No. 16321

IN NAME OF

WILLIE H. KOWITZ

Surveyed AUG. 12 1946 by [Signature]