


T.13S.R.6W.W.M.

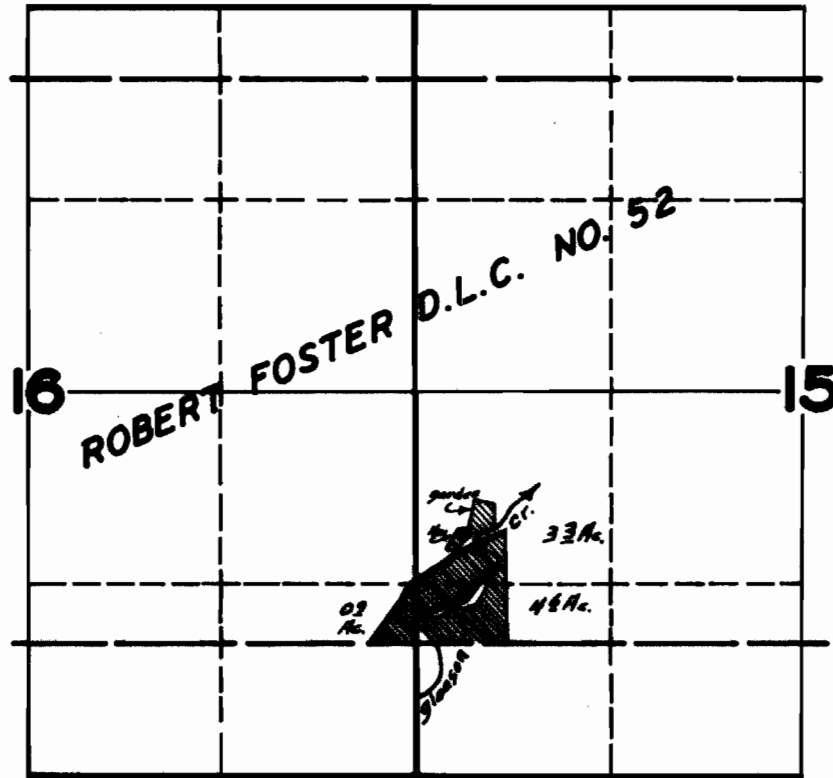

FINAL PROOF SURVEY UNDER

Application No. 20871 Permit No. 16347

IN NAME OF

H.E. THOMPSON

Surveyed MAY 28 1947, by JAS. E. BUNNELL