T. 2S, R. 2E.W.M.

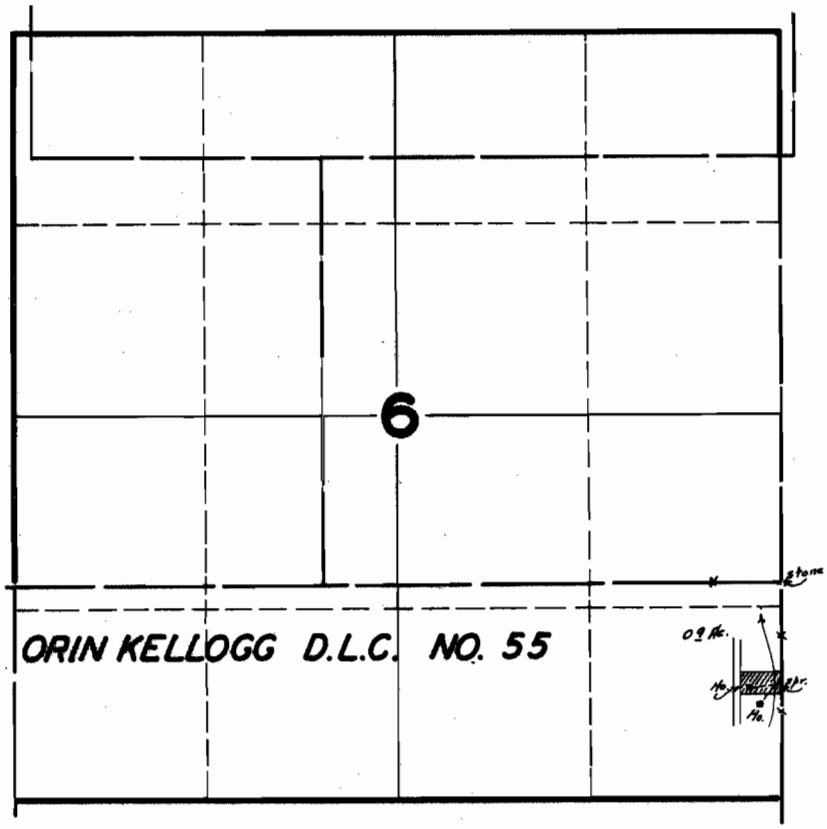

FINAL PROOF SURVEY

UNDER

Application No. 20879 Permit No. 16353

IN NAME OF

MICHAEL PETRI

Surveyed JUNE 11 1946, by

1946-D