


T. IN. R. 2 W. W. M.

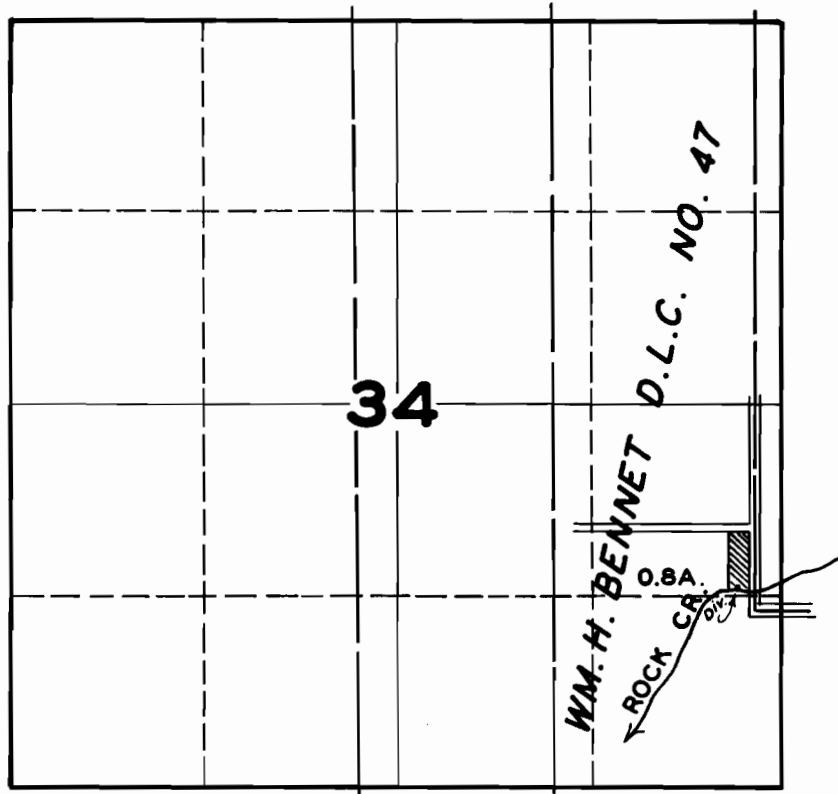

FINAL PROOF SURVEY

UNDER

Application No. **20925** Permit No. **16386**...

IN NAME OF

GLEN A. ROBSON

Surveyed **JUL. 31** 1947, by **JAS. E. BUNNELL**