


T.41S.R.13W.W.M.

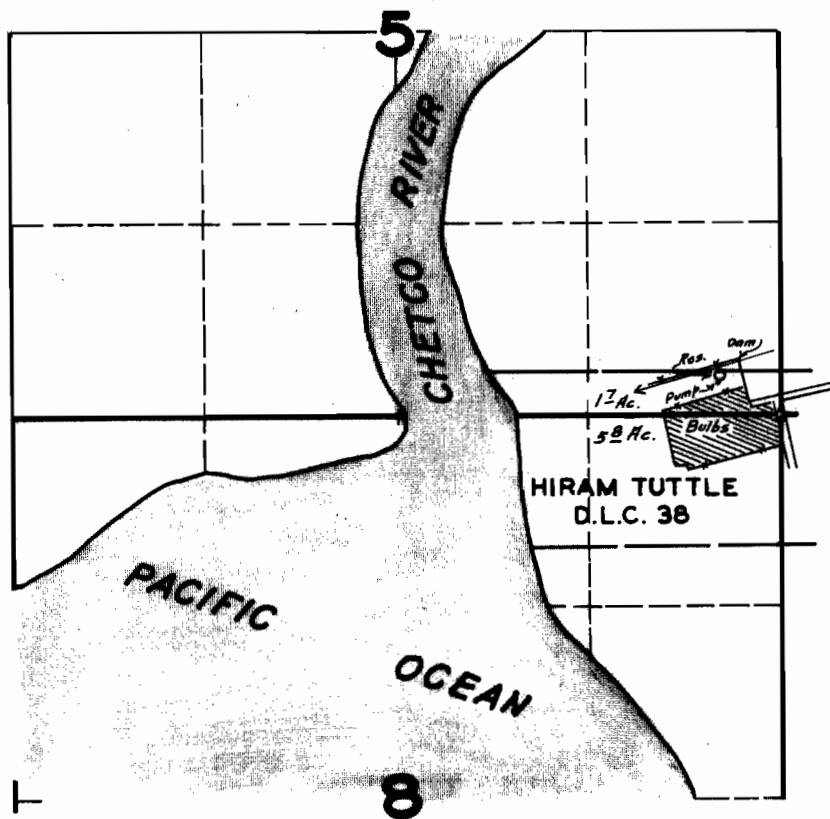

FINAL PROOF SURVEY
UNDER

Application No. 20973 Permit No. 16419

IN NAME OF

ANDREW HOFFELDT & ADRIEN HOFFELDT

Surveyed JUL. 21. 1947, by JAS. E. BUNNELL