


T.17S.R.10W.W.M.

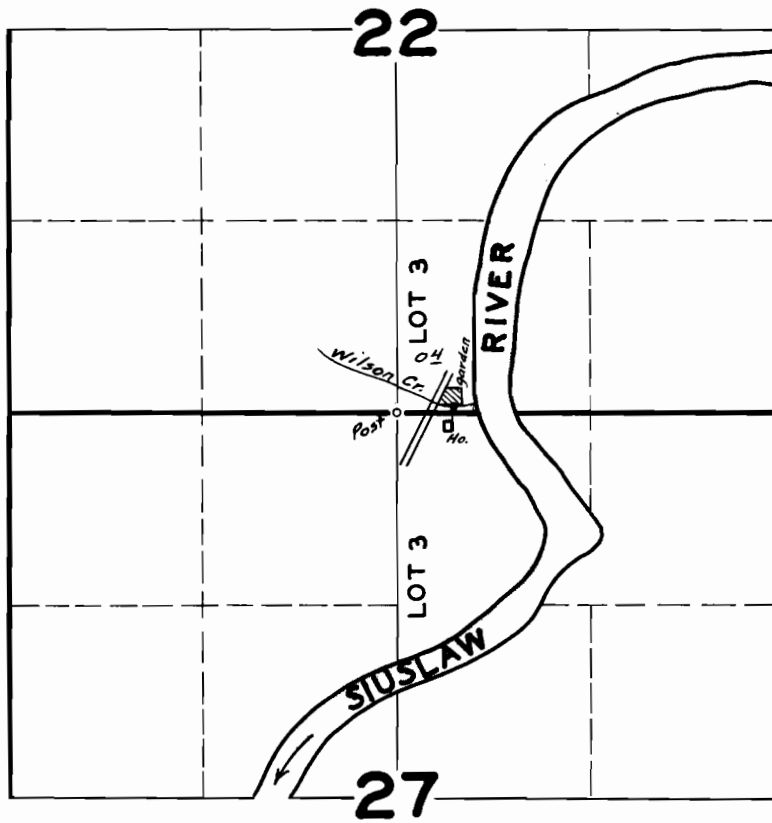

**FINAL PROOF SURVEY  
UNDER**

Application No. 20986 Permit No. 16426

IN NAME OF

GEO. H. WILSON

Surveyed AUG. 12, 1947, by JAS. E. BUNNELL