


T.9S.R.4W.W.M.

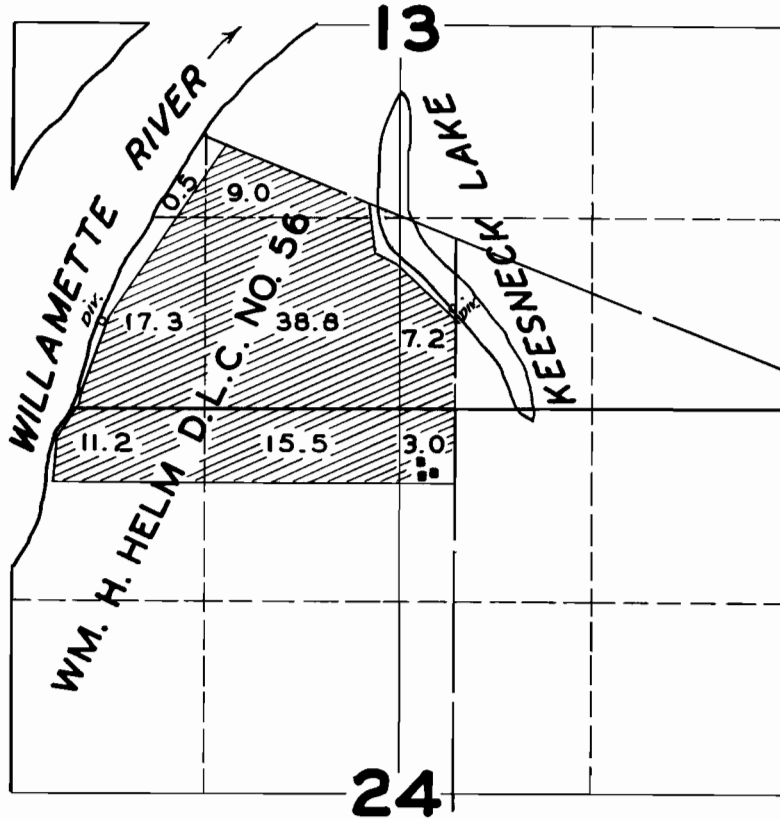

FINAL PROOF SURVEY

UNDER

Application No. 21017 Permit No. 16480

IN NAME OF

JOHN ZEHNER

Surveyed APR. 27, 1949, by JAS. E. BUNNELL