


T.6S.R.1E.W.M.

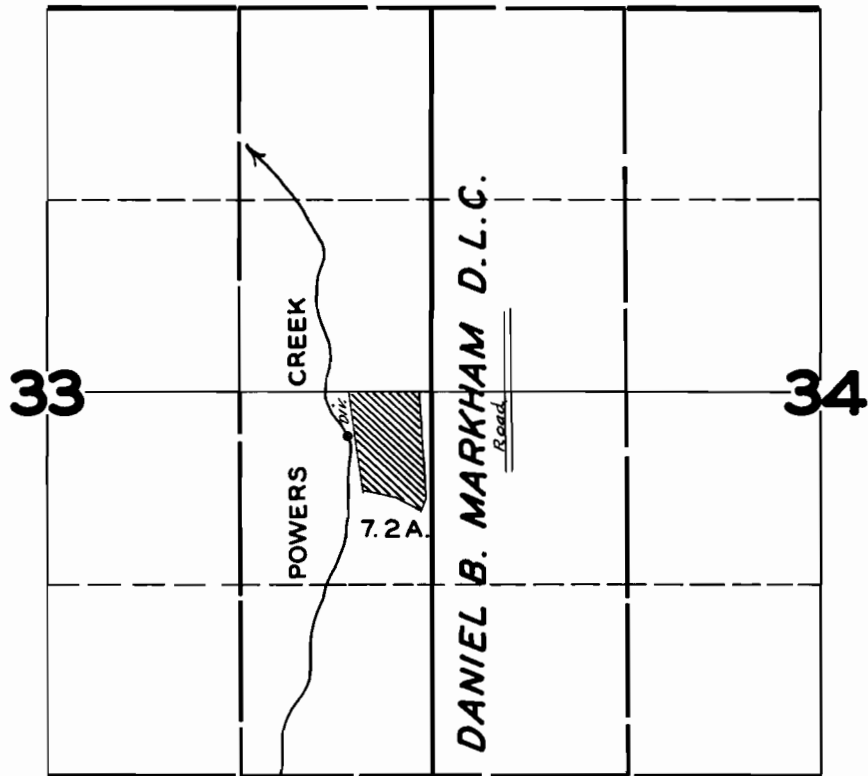

FINAL PROOF SURVEY UNDER

Application No. 21040 Permit No. 16485

IN NAME OF
NEIL VERBECK

Surveyed JUL. 30, 1947, by JAS. E. BUNNELL