


T.14S.R.1E.W.M.

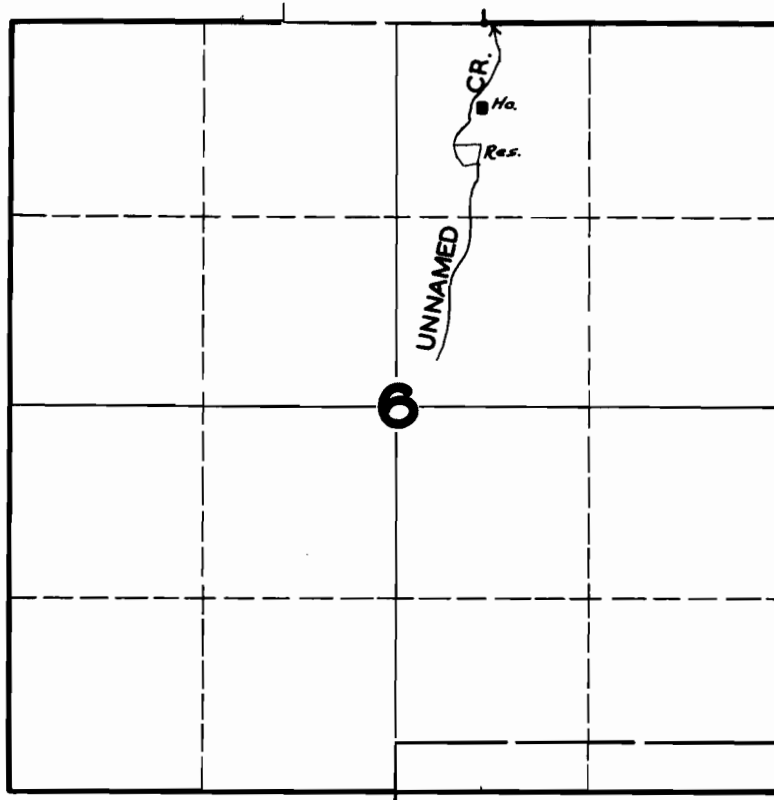

FINAL PROOF SURVEY
UNDER

Application No. 21056 Permit No. 16499
IN NAME OF

MR. CLEO THOMPSON

Surveyed APR. 26 1948, by JAS. E. BUNNELL