


T.3S.R.2W.W.M.

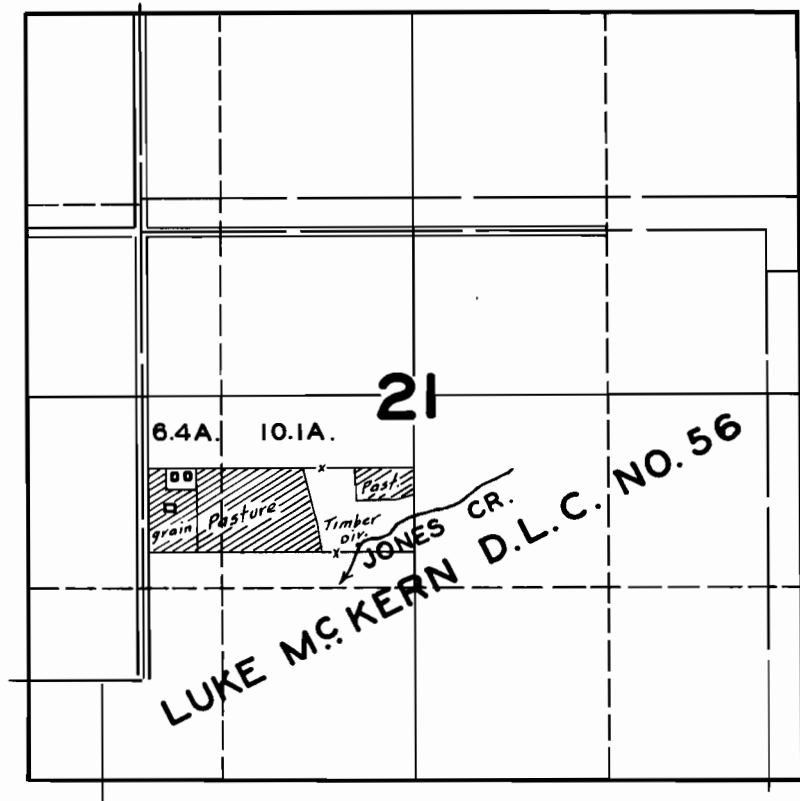

FINAL PROOF SURVEY
UNDER

Application No. **21064** Permit No. **16507**

IN NAME OF

GEORGE HICKERT

Surveyed **JUN. 27, 1947**, by **JAS. E. BUNNELL**