


# T.41S.R.13W.W.M.

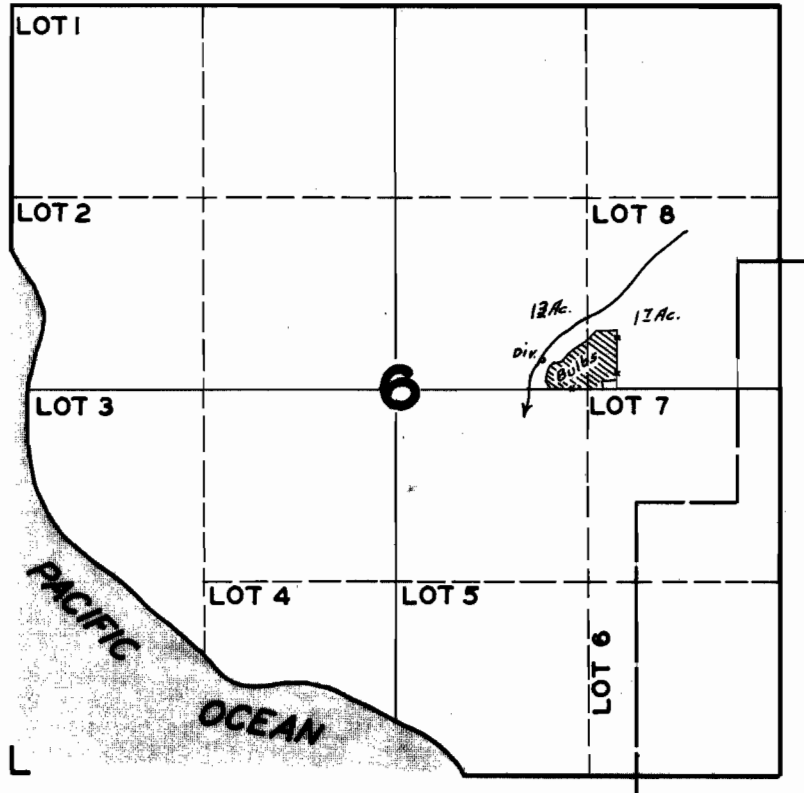

## FINAL PROOF SURVEY UNDER

Application No. 21066 Permit No. 16509

IN NAME OF

J. M. FRAZER

Surveyed JUL. 22. 1947. by JAS. E. BUNNELL