


T.13S.R.1E.W.M.

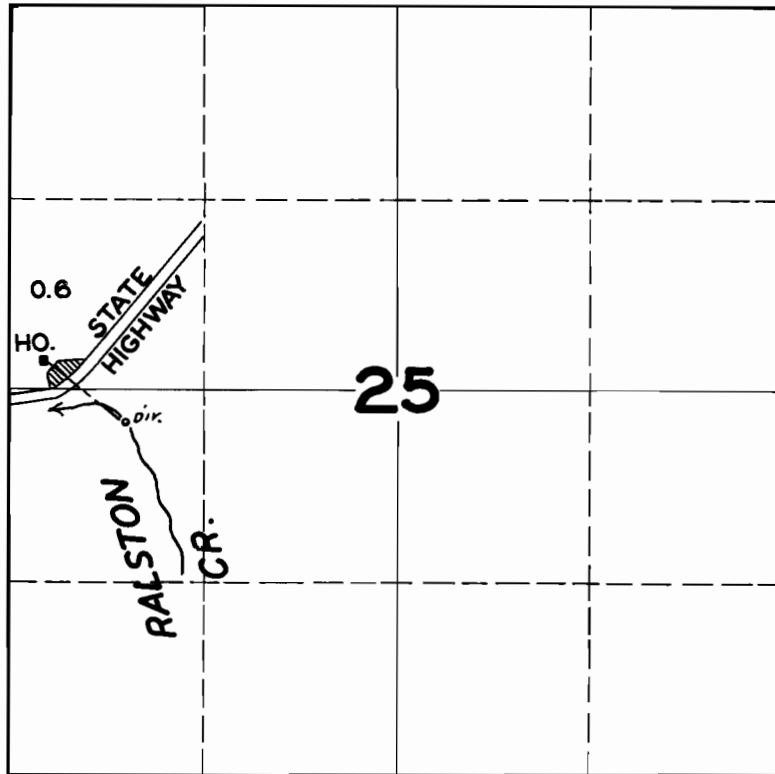

FINAL PROOF SURVEY

UNDER

Application No. **21085**... Permit No. **16523**...

IN NAME OF

HAGLE BROS.

Surveyed **APR. 27 1949**, by **JAS. E. BUNNELL**