


T.3S.R.2W.W.M.

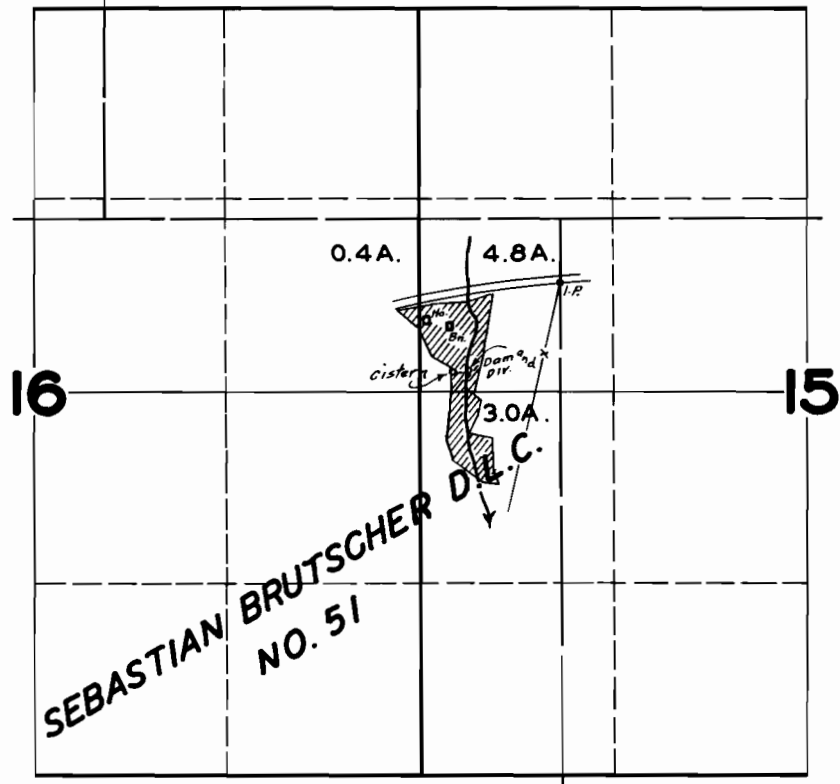

FINAL PROOF SURVEY UNDER

Application No. 21098 Permit No. 16533
IN NAME OF

T.W. McDONALD

Surveyed SEP. 19 1947, by JAS. E. BUNNELL