


T.22S.R.9W.W.M.

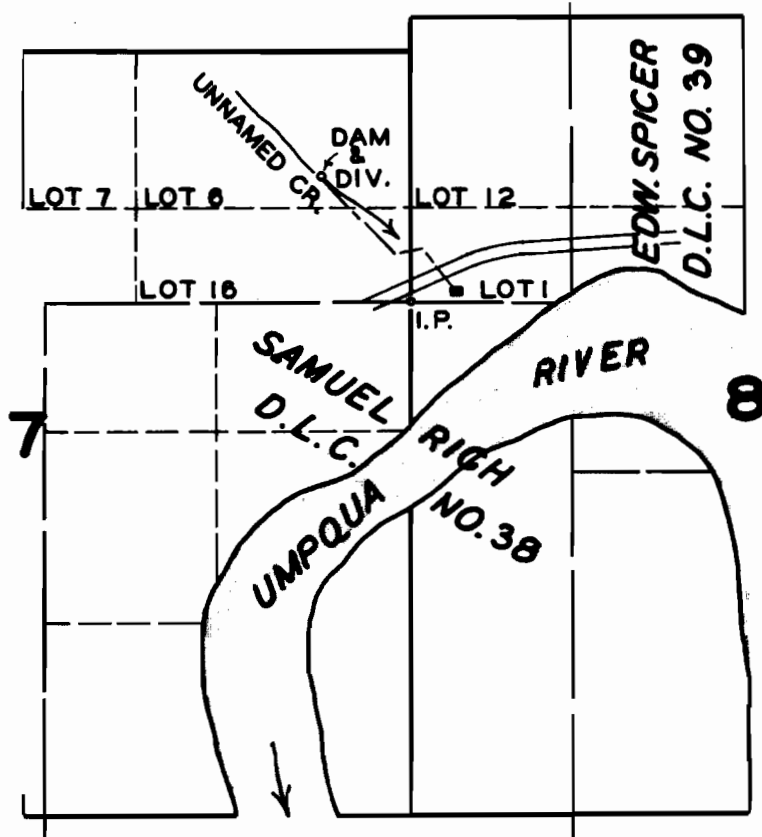

FINAL PROOF SURVEY
UNDER

Application No. 21140 Permit No. 16568
IN NAME OF

WILLIAM L. HANSEN & THELMA H. HANSEN

Surveyed JULY 13 1948, by JAS. E. BUNNELL