


T.3S.R.2W.W.M.

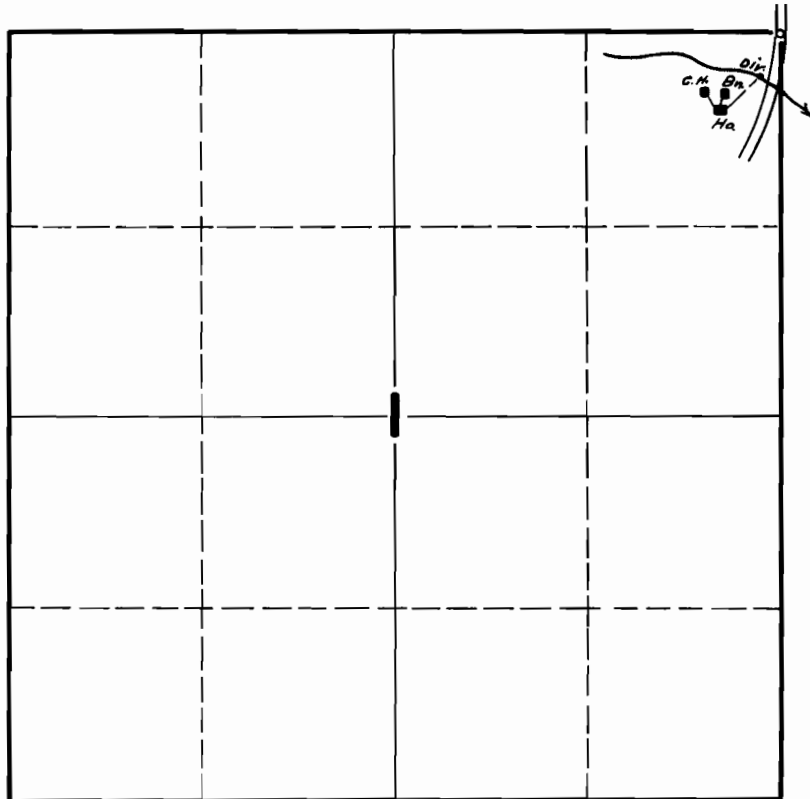

FINAL PROOF SURVEY
UNDER

Application No. **21142** Permit No. **16569**
IN NAME OF

JESSE ALLEN CHAUSSE

Surveyed **MAY 4** 1948, by **JAS. E. BUNNELL**