


T.2S.R.44E.W.M.

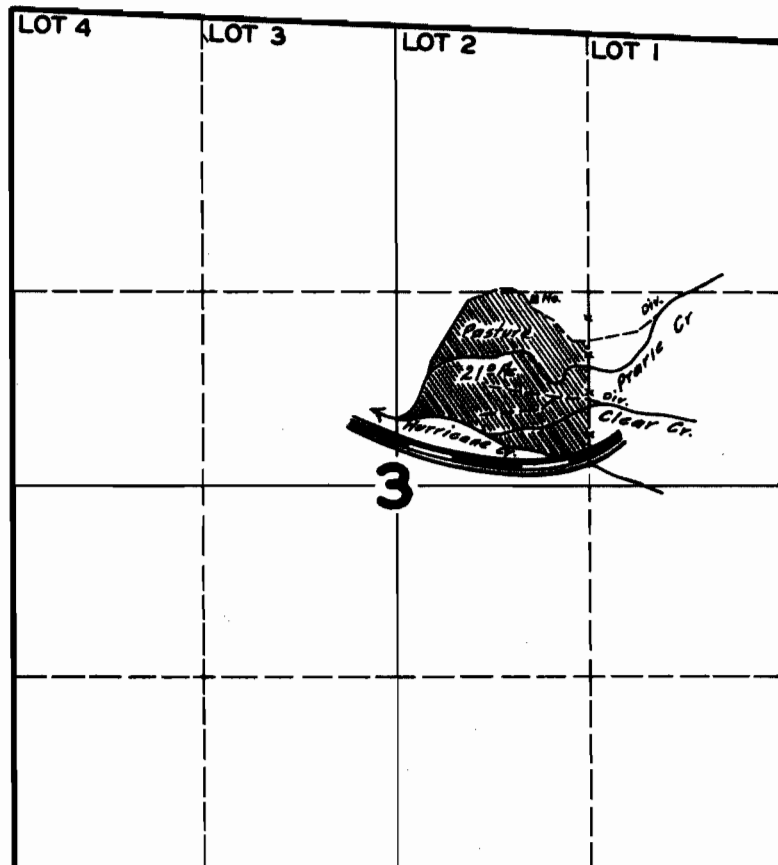

FINAL PROOF SURVEY UNDER

Application No. 21193 Permit No. 16610

IN NAME OF

O. L. PAGE

Surveyed JUNE 27 1946, by JAS. E. BUNNELL