


T.5S.R.7W.W.M.

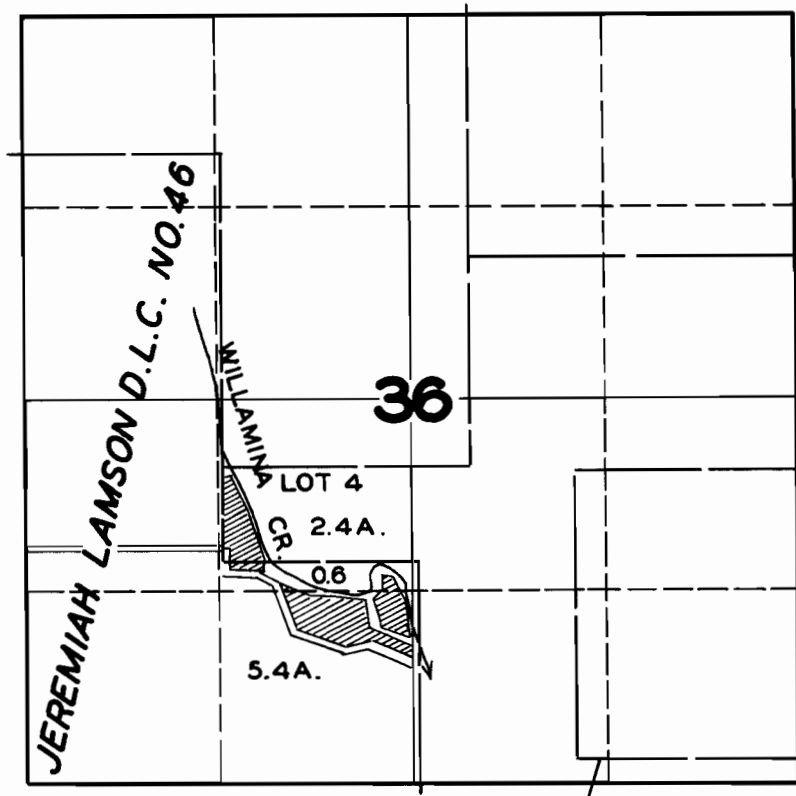

FINAL PROOF SURVEY UNDER

Application No. **21194** Permit No. **16611**

IN NAME OF

O.K. BROCK

Surveyed **SEP. 19** 1947, by **JAS. E. BUNNELL**