


**T.6N.R.35E.W.M.**

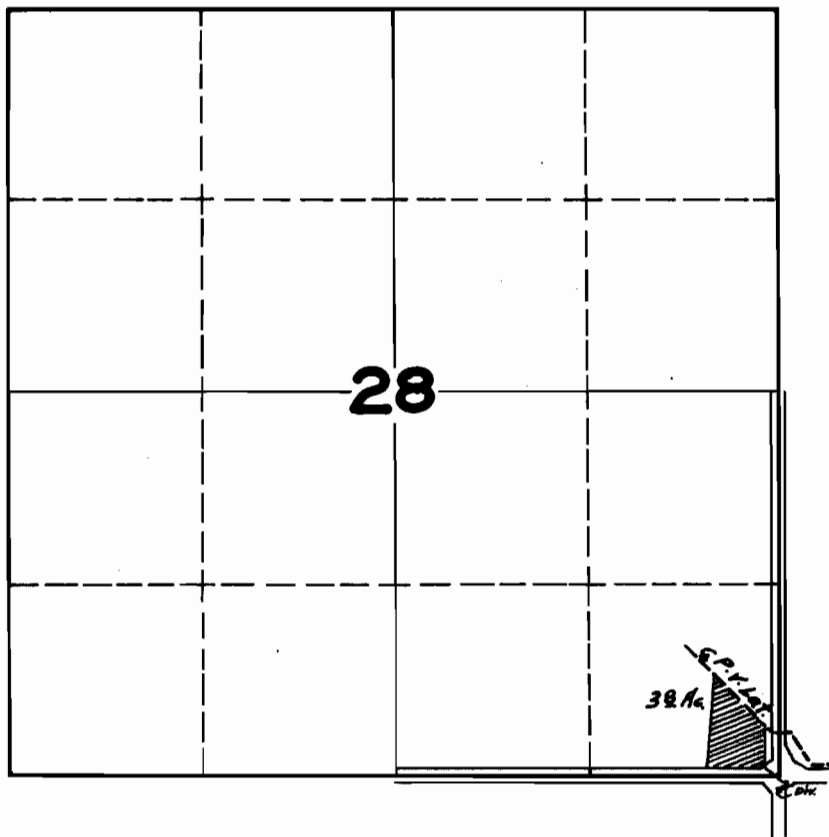

**FINAL PROOF SURVEY  
UNDER**

**Application No. 21204 Permit No. 16621**

**IN NAME OF**

**J. M. HANSON**

**Surveyed APR. 21 1947, by JAS. E. BUNNELL**