


T.41S.R.13W.W.M.

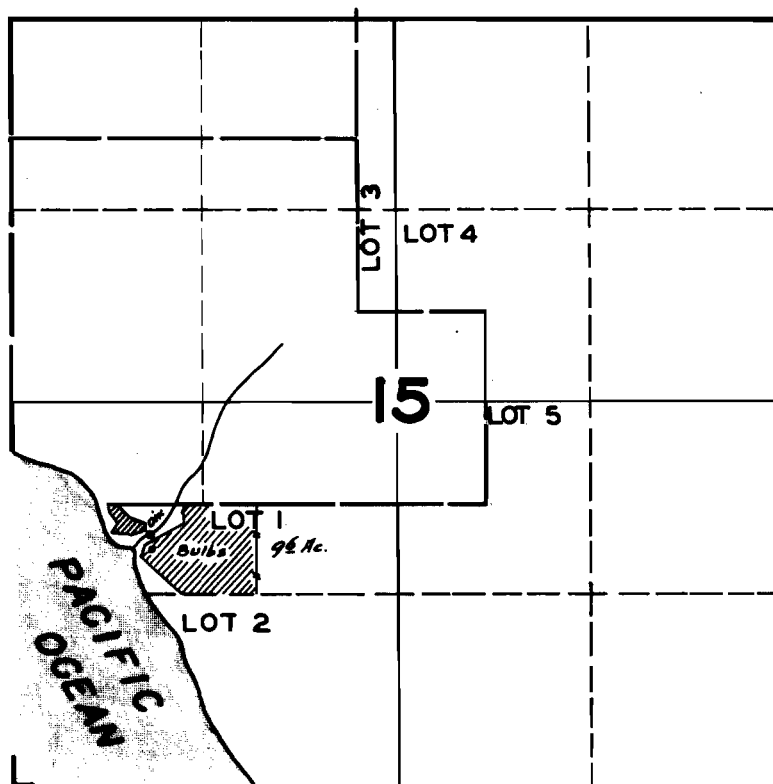

FINAL PROOF SURVEY
UNDER

Application No. 21221 Permit No. 16633

IN NAME OF

ALVIN WOODRIF

Surveyed JUL. 21. 1947, by JAS. E. BUNNELL