


T.2S.R.9W.W.M.

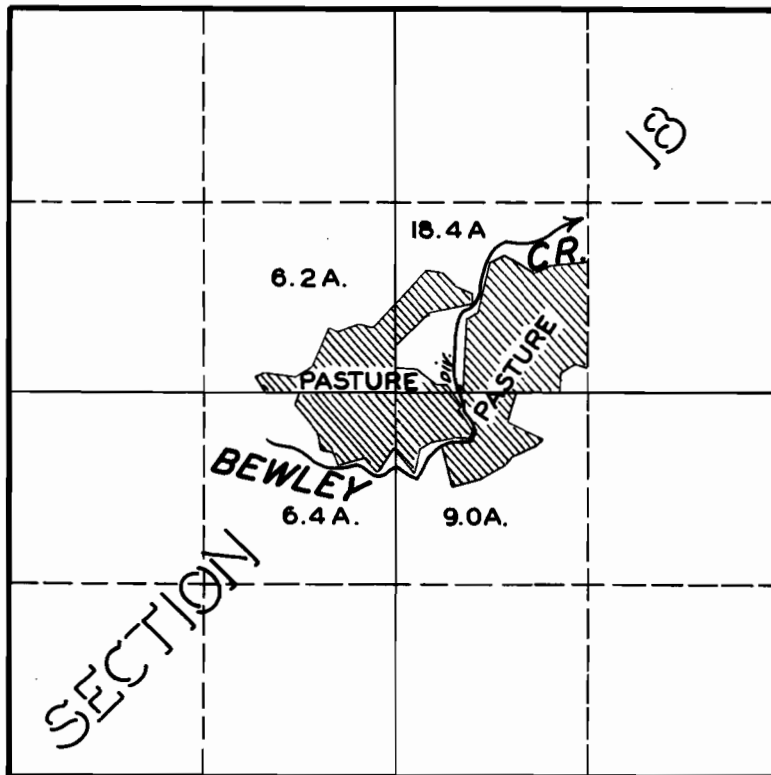

FINAL PROOF SURVEY

UNDER

Application No. 21250 Permit No. 16654

IN NAME OF

EVART R. BOGE

Surveyed SEP. 20, 1948, by JAS. E. BUNNELL