


T.I.S.R.2W.W.M.

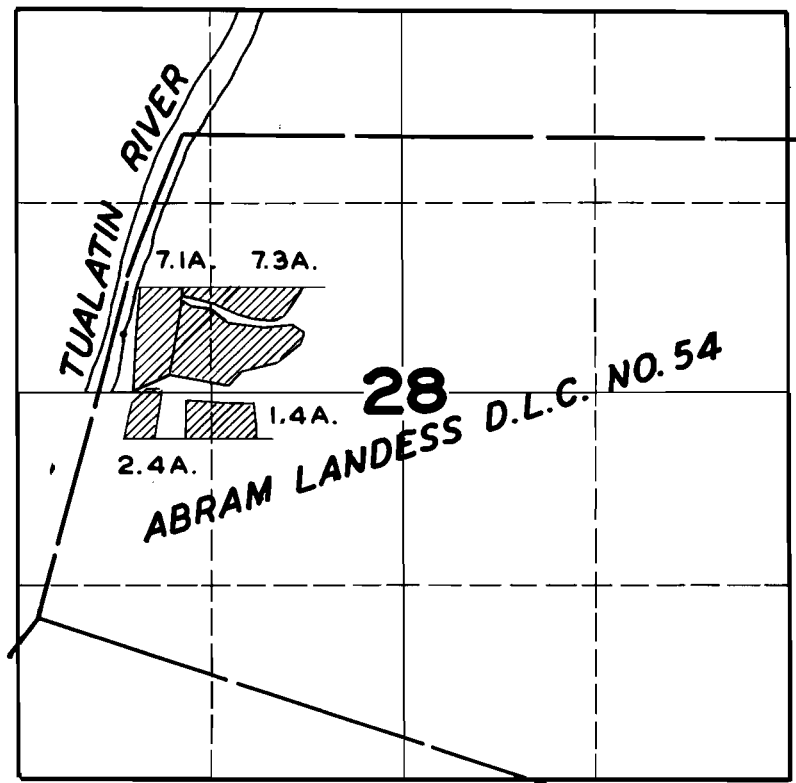

FINAL PROOF SURVEY
UNDER

Application No. ~~21284~~ Permit No. ~~16677~~
IN NAME OF

V. H. VAN DEHEY

Surveyed MAY 20 1948, by JAS. E. BUNNELL