


# T.5S.R.7W.W.M.

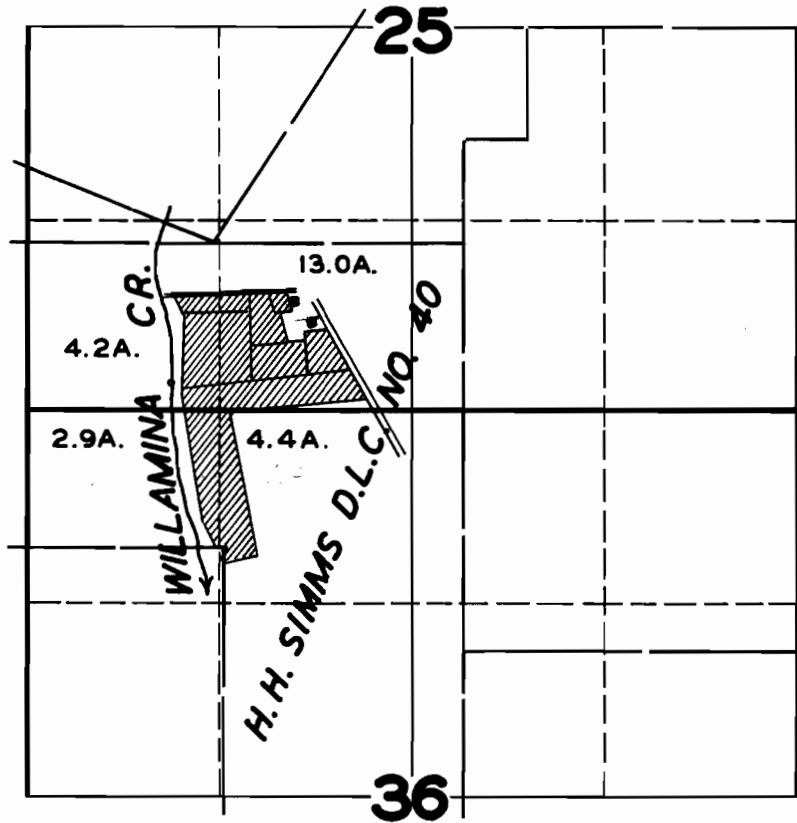

29  
20  
42

## FINAL PROOF SURVEY

UNDER

Application No. 21347 Permit No. 16679

IN NAME OF

VERNON D. RIGGLE

Surveyed JUNE 12, 1948, by JAS. E. BUNNELL