


T.26S. R.6W.W.M.

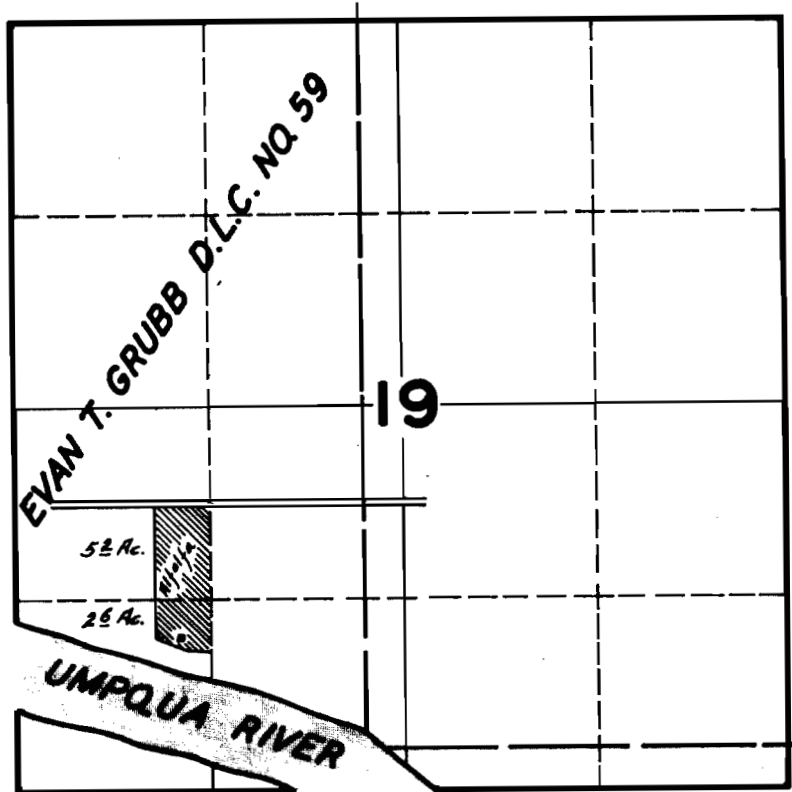

**FINAL PROOF SURVEY
UNDER**

Application No. 21297 Permit No. 16700

IN NAME OF

E. J. BRODERSEN

Surveyed JULY 11, 1947, by JAS. E. BUNNELL