


T.6S. R.1W.W.M.

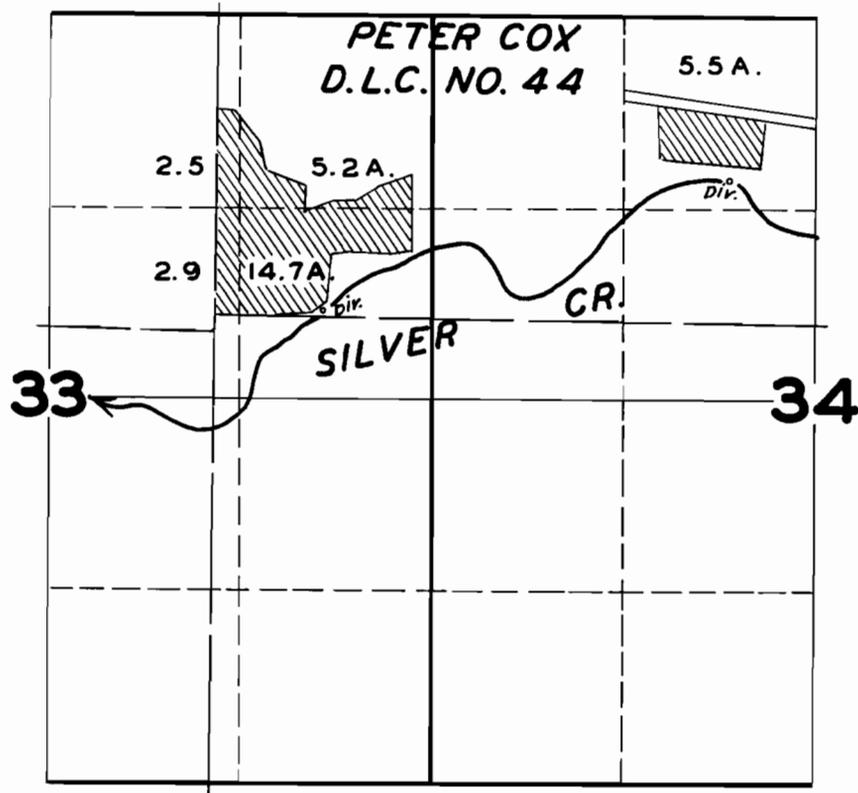

FINAL PROOF SURVEY

UNDER

Application No. **21300**... Permit No. **16703**...

IN NAME OF

G. A. SATHER

Surveyed **APR. 18, 1949**, by **JAS. E. BUNNELL**