


T.5S. R.6W.W.M.

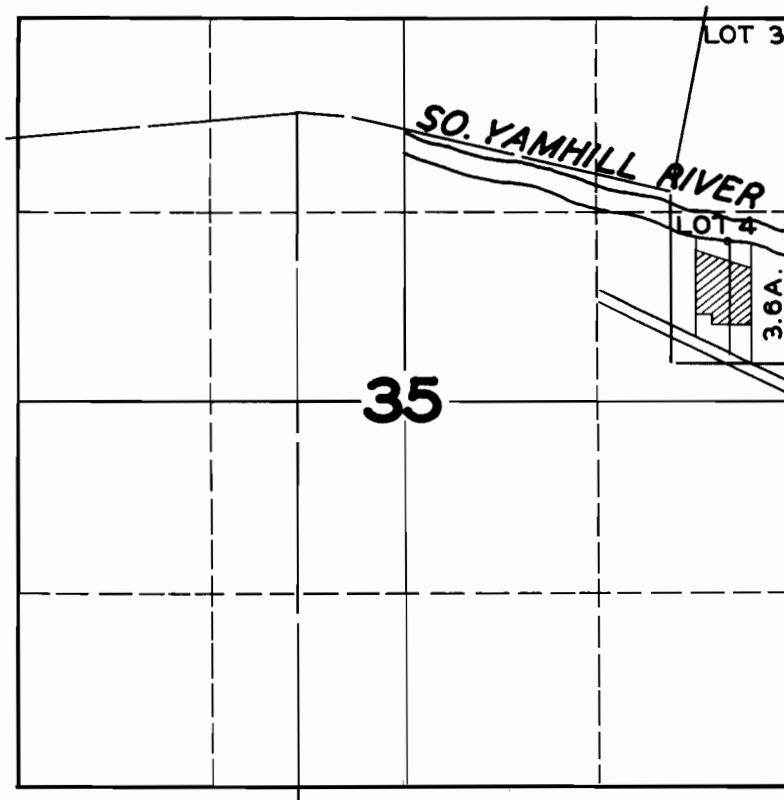

FINAL PROOF SURVEY

UNDER

Application No. **21307**... Permit No. **16710**.....

IN NAME OF

LUTHER HYDER.....

Surveyed **AUG. 20 1948**, by **JAS. E. BUNNELL**