


T.7S.R.3W.W.M.

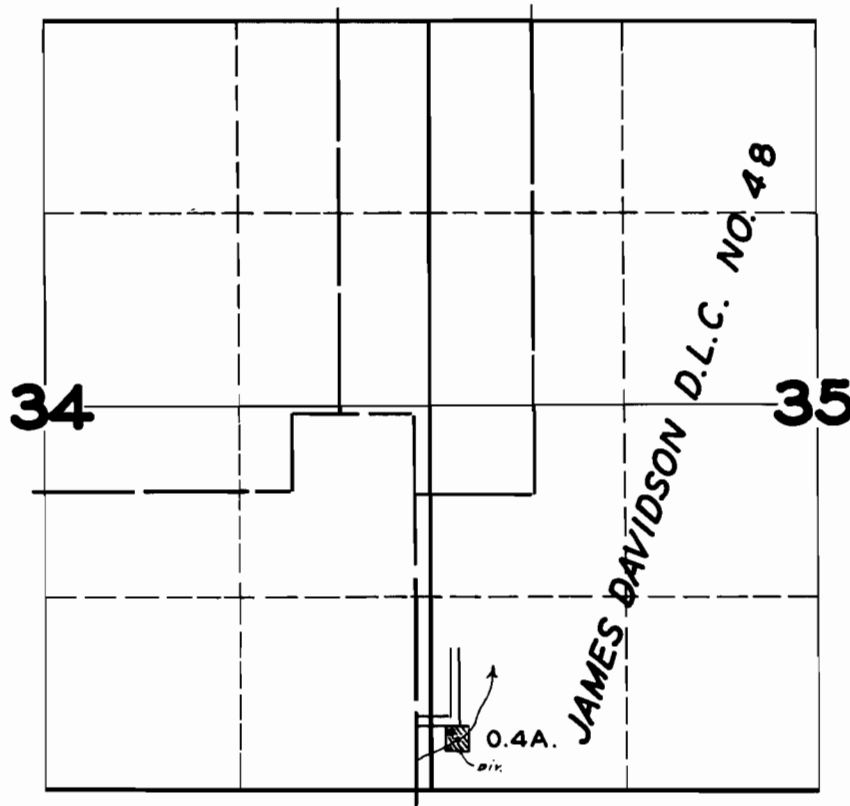

FINAL PROOF SURVEY
UNDER

Application No. **21323** Permit No. **16719**
IN NAME OF

WM. F. SANDERS & EUNICE M. SANDERS

Surveyed **APRIL 1, 1947**, by **JAS. E. BUNNELL**