


T.4S.R.10W.W.M.

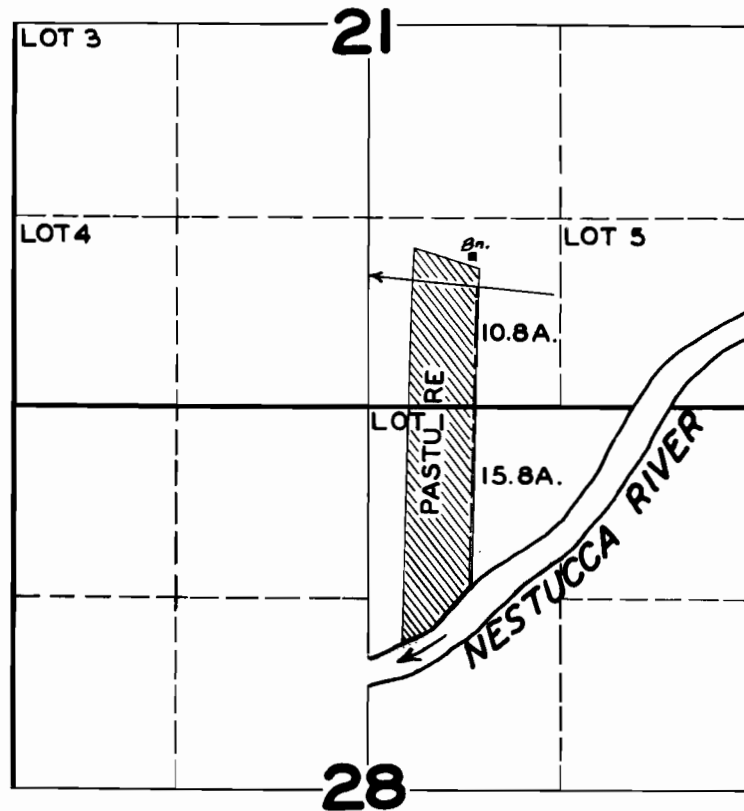

FINAL PROOF SURVEY
UNDER

Application No. 21371..... Permit No. 16742.....
IN NAME OF

.....LEON F. HANCOCK.....

Surveyed AUG. 31... 1948, by JAS. E. BUNNELL