


T.15S.R.12W.W.M.

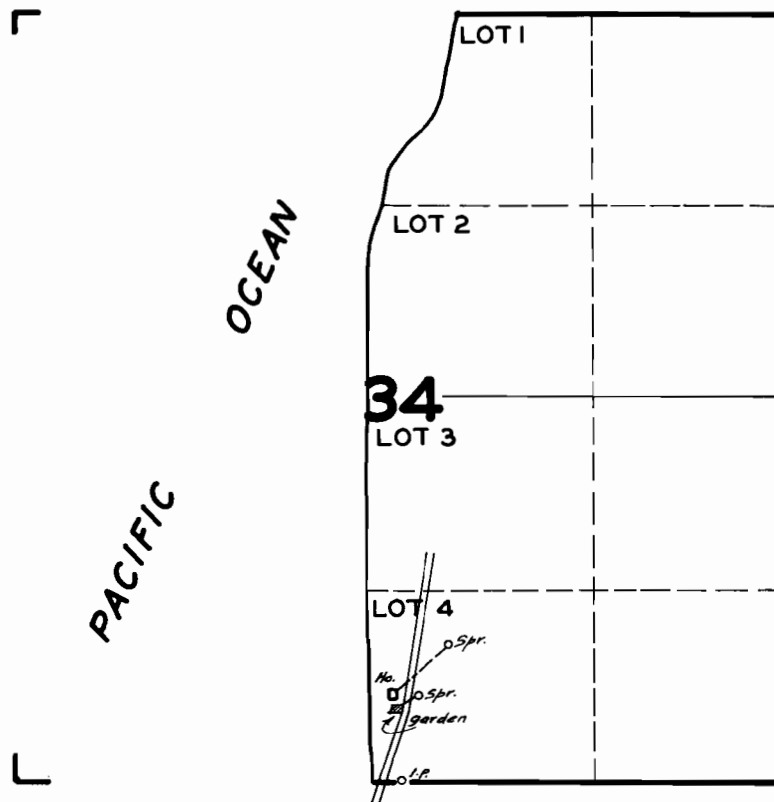

FINAL PROOF SURVEY
UNDER

Application No. 21378 Permit No. 16746

IN NAME OF

THOMAS E. & JESSIE L. SCOBEE

Surveyed AUG. 13 1947, by JAS. E. BUNNELL