


T.19S.R.11W.W.M.

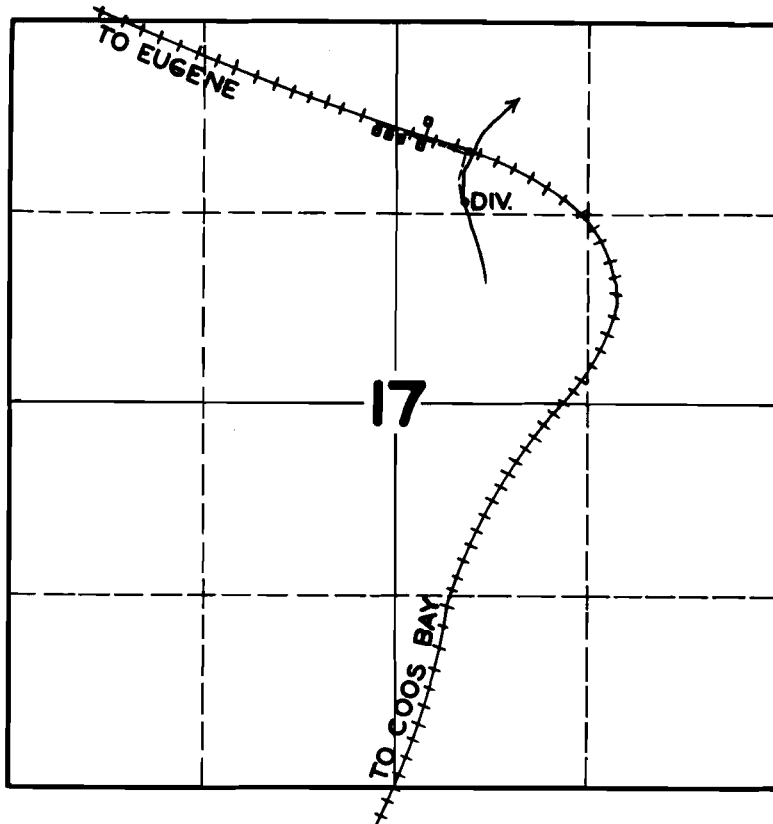

FINAL PROOF SURVEY

UNDER

Application No. 21404 Permit No. 16758

IN NAME OF

SOUTHERN PACIFIC COMPANY

Surveyed JULY 26 1948, by JAS. E. BUNNELL