


T. 2S. R. 9W. W.M.

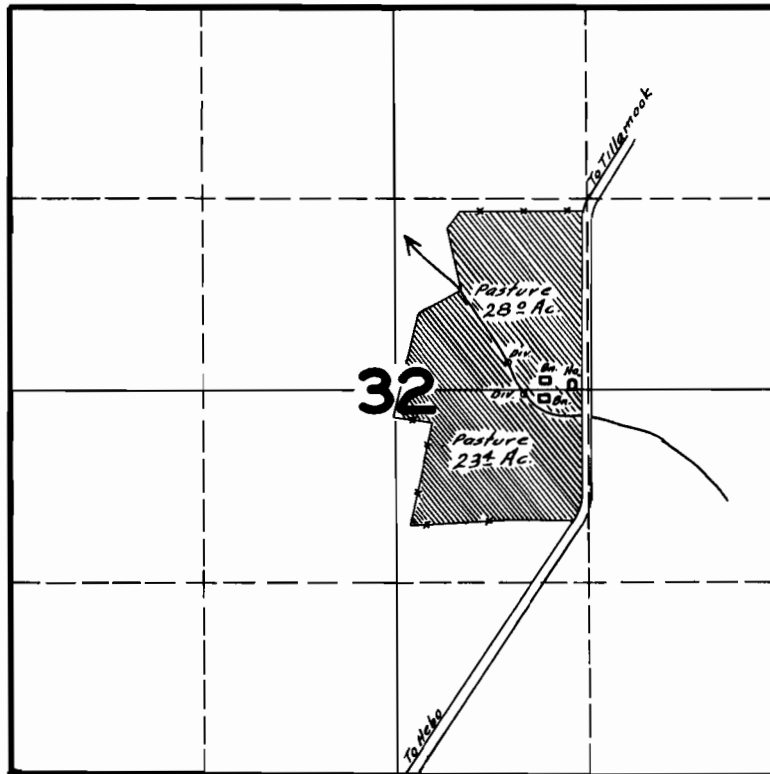

**FINAL PROOF SURVEY**  
UNDER

Application No. 21376 Permit No. 16791

IN NAME OF

ERNEST W. PALLIN

Surveyed JULY 18 1946 by [Signature]