


# T.5N. R.36E. W.M.

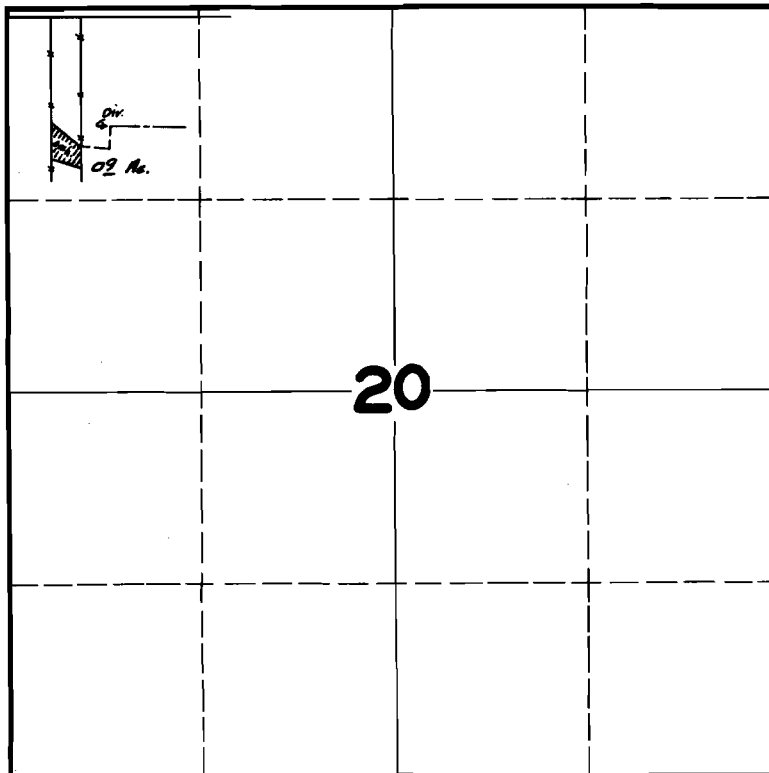

## FINAL PROOF SURVEY UNDER

Application No. 21414 Permit No. 16793

IN NAME OF

R. H. HARRINGTON

Surveyed APR. 22 1947. by JAS. E. BUNNELL