


# T.5N.R.36E.W.M.

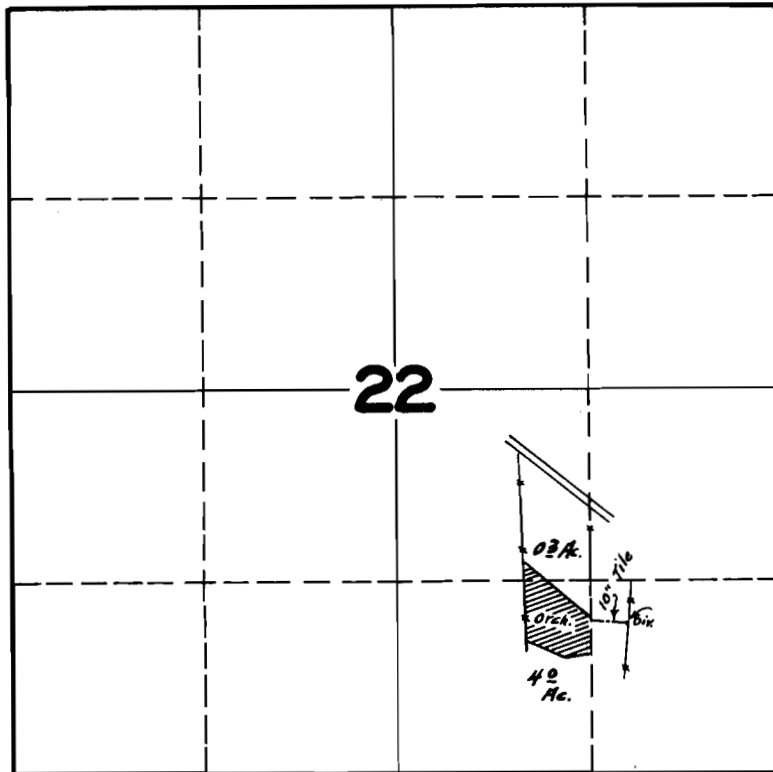

## FINAL PROOF SURVEY UNDER

Application No. 21415 Permit No. 16794

IN NAME OF  
J. H. DAY

Surveyed APR. 22 1947, by JAS. E. BUNNELL