


T.38S. R.14W.W.M.

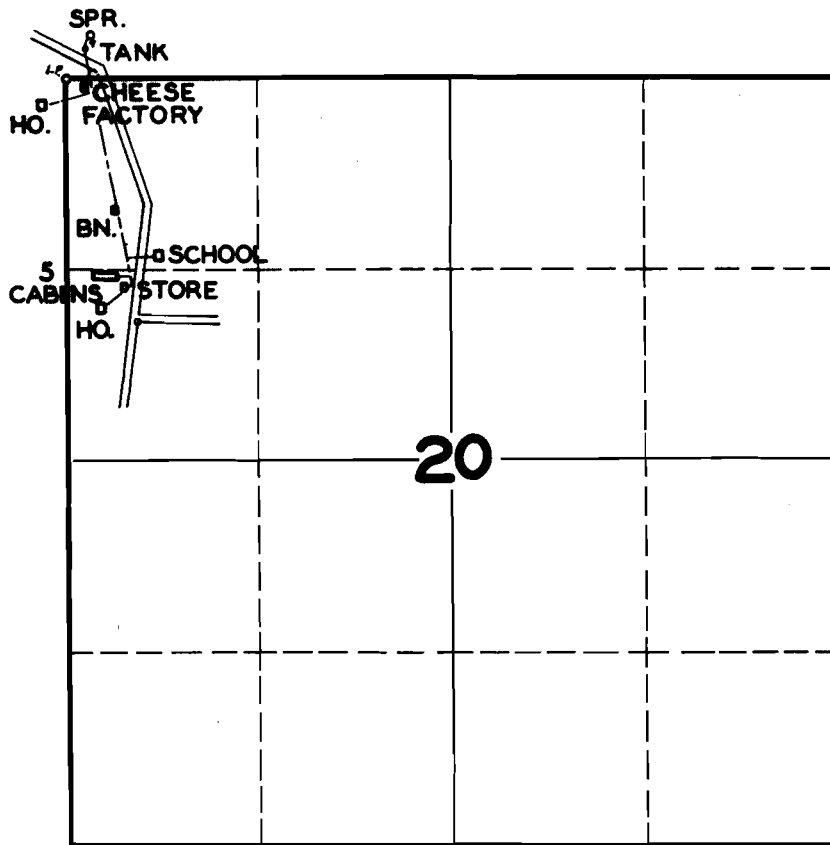

FINAL PROOF SURVEY UNDER

Application No. 21417 Permit No. 16802

IN NAME OF

W. J. WALKER

Surveyed JUL. 22 1947, by JAS. E. BUNNELL