


**T.17S.R.3W.W.M.**

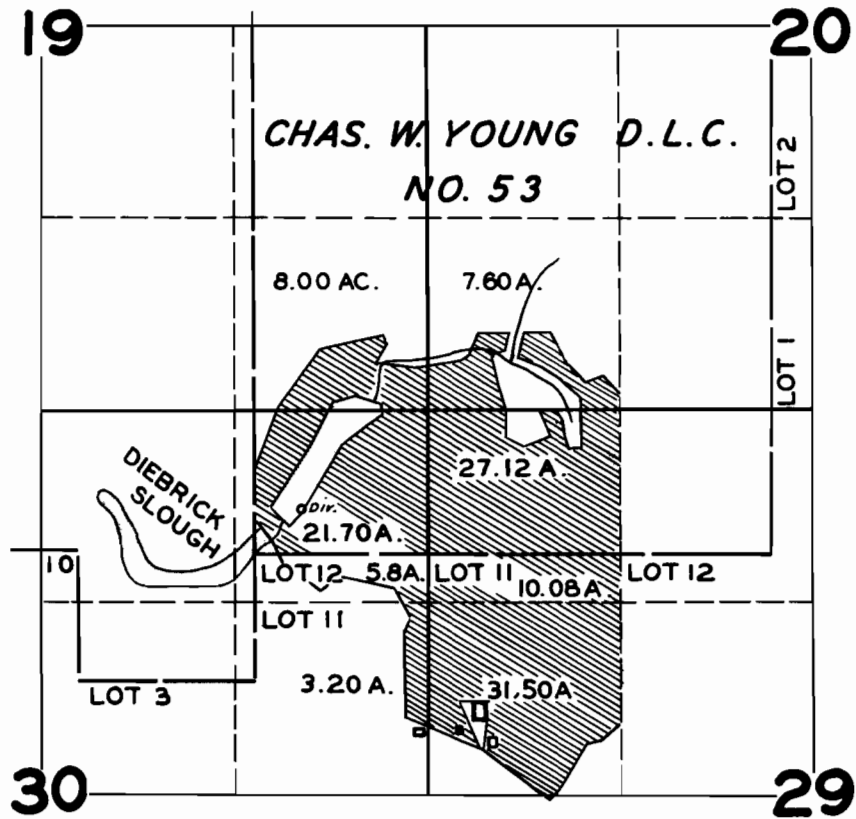

**FINAL PROOF SURVEY  
UNDER**

**Application No. 21436 Permit No. 16817**

**IN NAME OF**

**EUGENE GOLF & COUNTRY CLUB**

**Surveyed AUG. 8, 1947, by JAS. E. BUNNELL**