


T.15S.R.8W.W.M.

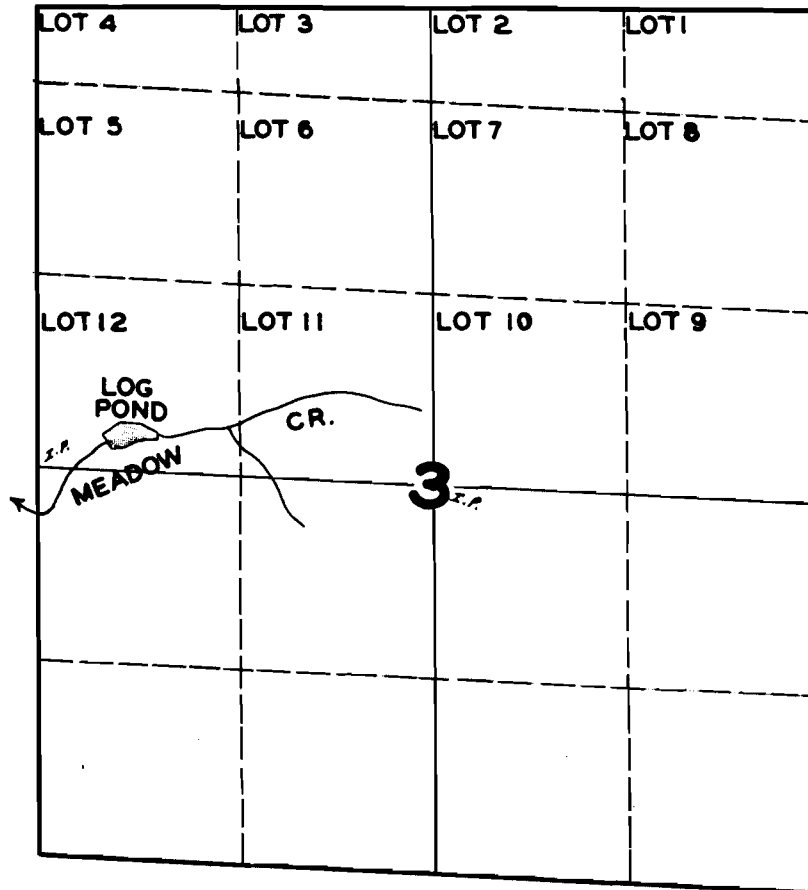

**FINAL PROOF SURVEY
UNDER**

Application No. 21493 Permit No. 16858

IN NAME OF

HOWARD W. MARTIN

Surveyed JUL. 16. 1947, by JAS. E. BUNNELL