


T.29S. R.6W.W.M.

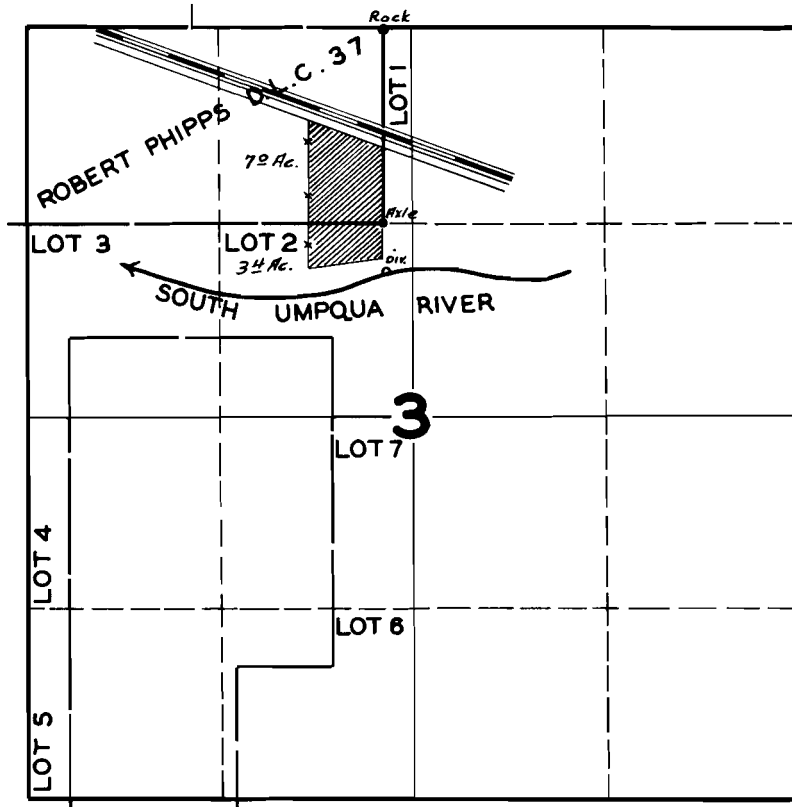

FINAL PROOF SURVEY

UNDER

20411

15939

Application No. 21495 Permit No. 16859

IN NAME OF

GEO. O. & INA UPDEGRAFF

Surveyed JUNE 2, 1947, by JAS. E. BUNNELL