


T.9S.R.1E.W.M.

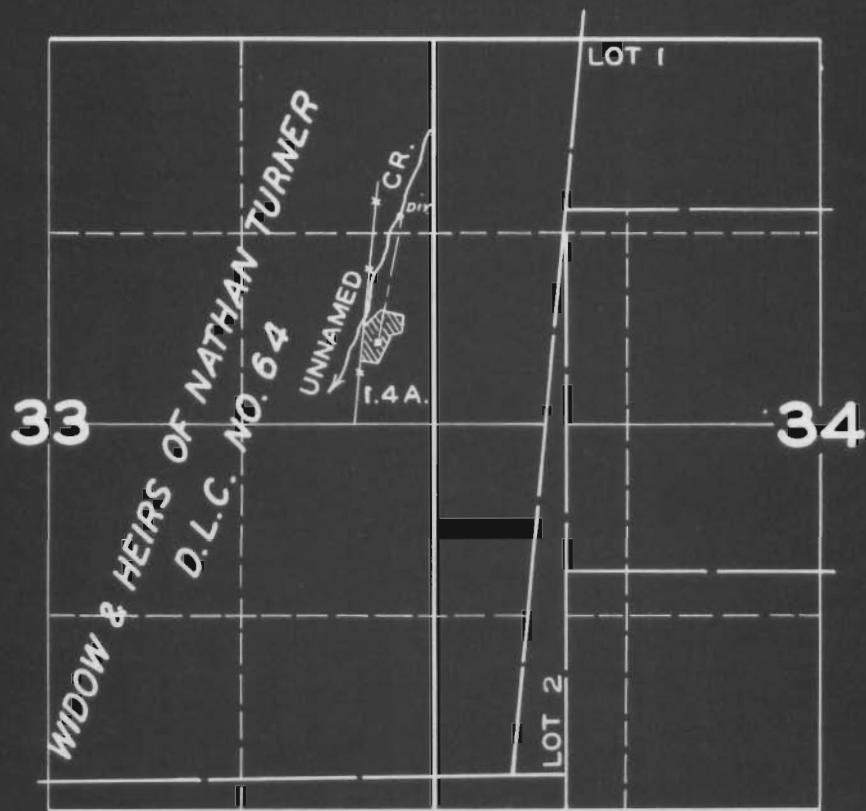

FINAL PROOF SURVEY
UNDER

Application No. 21550 Permit No. 16897
IN NAME OF

J. C. SILBERNAGEL

Surveyed APR. 4 1949, by JAS. E. BUNNELL