


T.7S.R.IW.W.M.

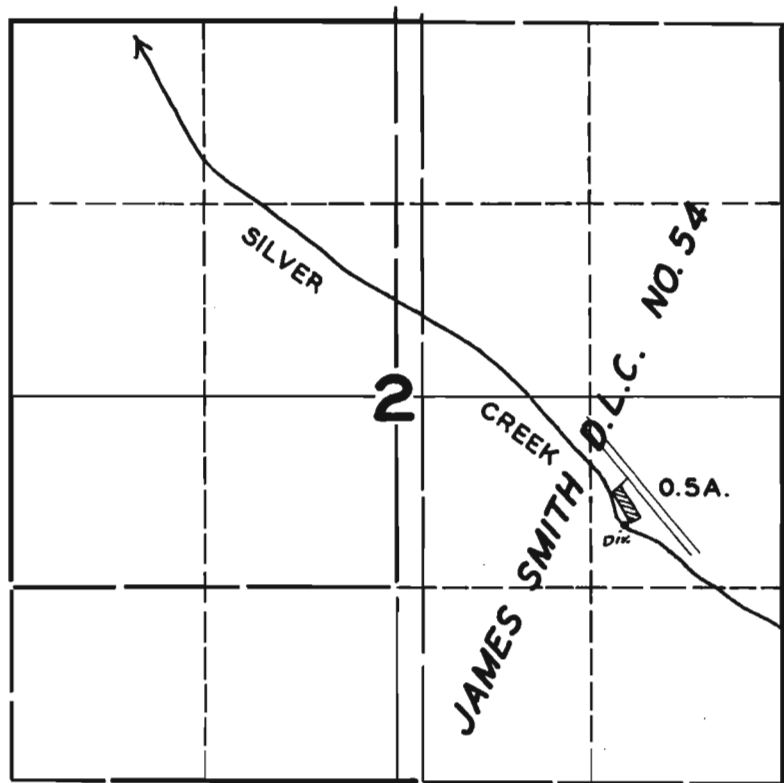

FINAL PROOF SURVEY UNDER

Application No. 21465 Permit No. 16922
IN NAME OF

ALLEN T. GRIBBLE

Surveyed JUN. 25 1947, by JAS. E. BUNNELL