


T.4S.R.1E.W.M.

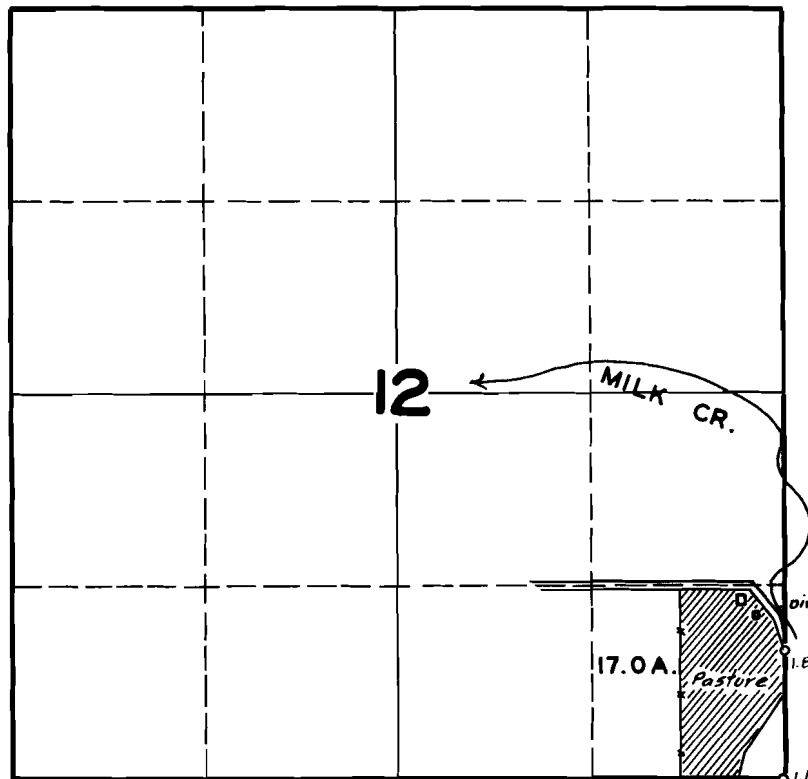

**FINAL PROOF SURVEY
UNDER**

Application No. 21585 Permit No. 16961

IN NAME OF

R. L. HANSEN

Surveyed SEP. 30, 1947, by JAS. E. BUNNELL