


T.30S.R.5W.W.M.

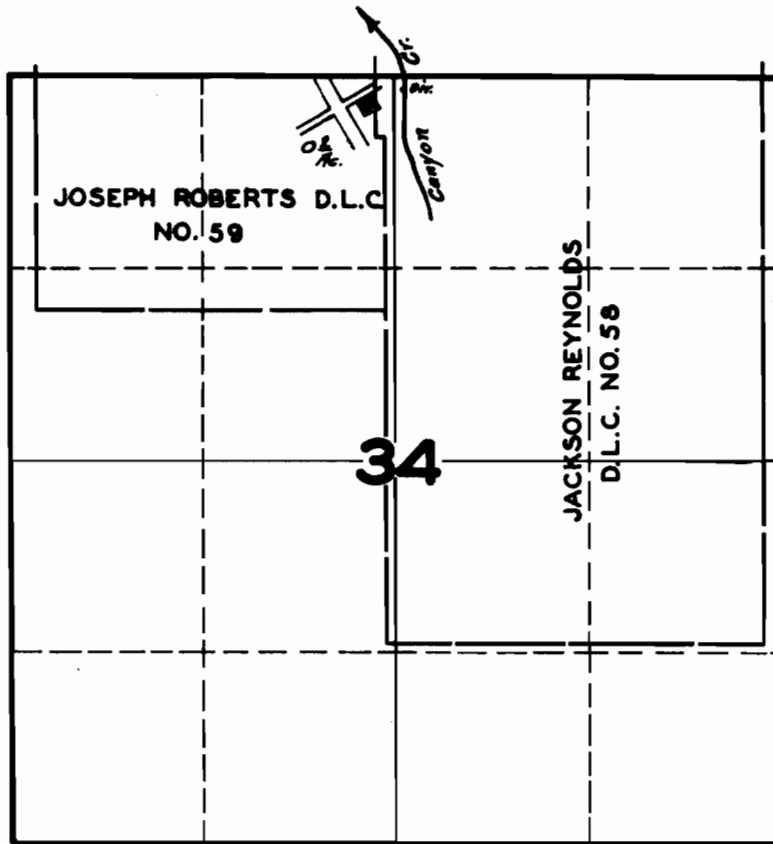

**FINAL PROOF SURVEY
UNDER**

Application No. 21616 Permit No. 16985

IN NAME OF

FRED H. ELLIOTT

Surveyed JULY 9 1947, by JAS. E. BUNNELL