


T.2S.R.2E.W.M.

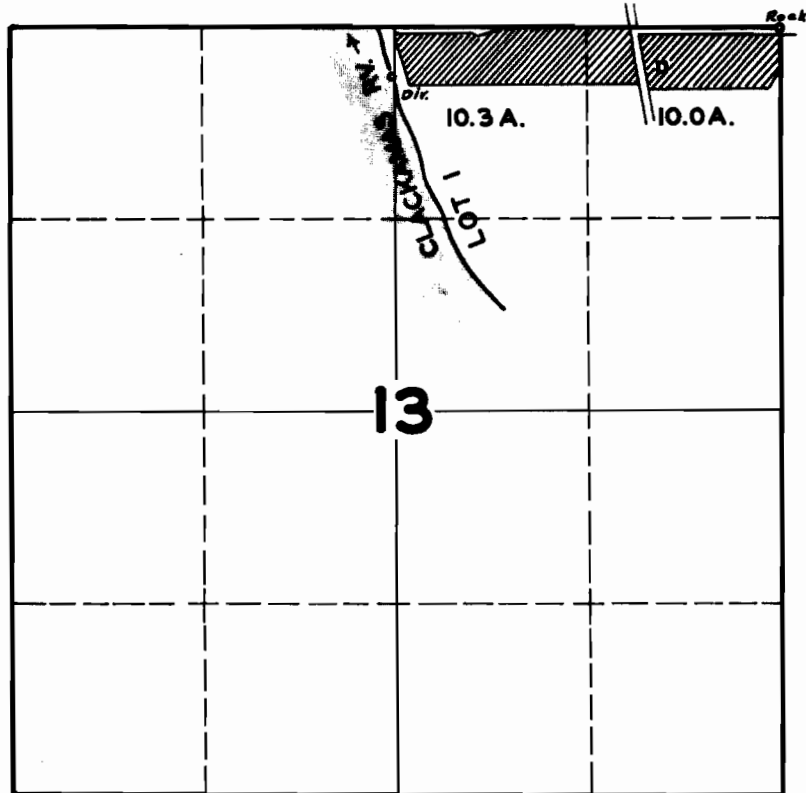

**FINAL PROOF SURVEY
UNDER**

Application No. 21626 Permit No. 16993

IN NAME OF

MRS. ESTHER QUEIROLO

Surveyed SEP. 30 1947, by JAS. E. BUNNELL