


T.16S. R.4W.W.M.

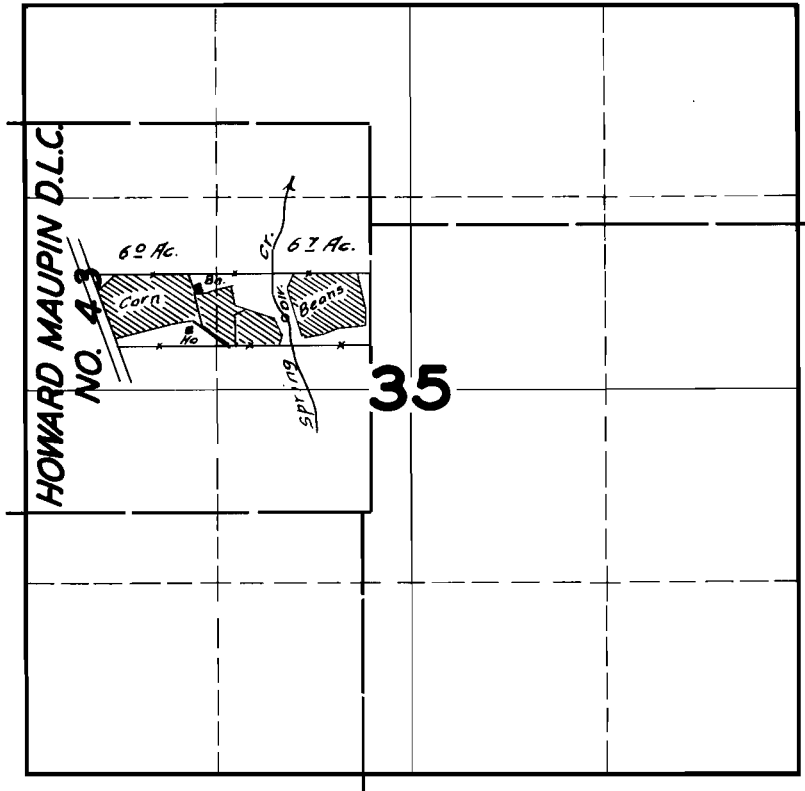

FINAL PROOF SURVEY UNDER

Application No. 21642 Permit No. 17003

IN NAME OF

FRED H. PETERS

Surveyed AUG. 8, 1947, by JAS. E. BUNNELL