


T.9S.R.2W.W.M.

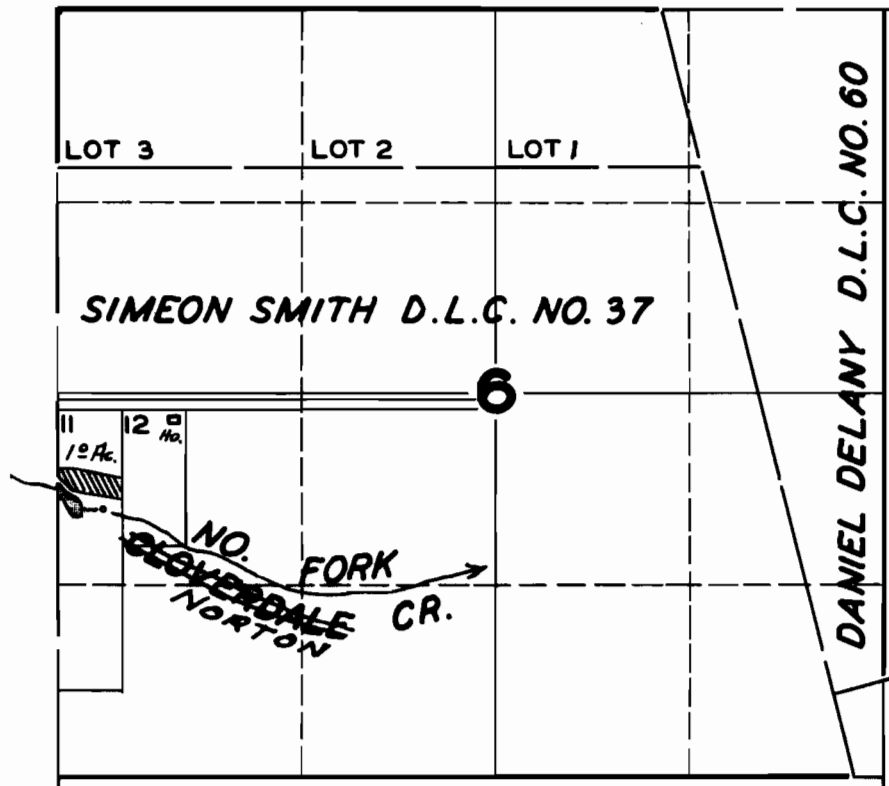

FINAL PROOF SURVEY

UNDER

21308

16711

Application No. **21691** Permit No. **17034**

IN NAME OF

EVERETT W. WHEALDON

MAR 30 49

Surveyed **AUG. 27, 1948**, by **JAS. E. BUNNELL**